

Name

Service No.

Address 13 CUTTER Farm RD

Location

Kind of Pipe PVC

Size 6"

Size of Main 8" AC

Repair—Renewal—New Service T.D.J. Peacock

Location


Date	Material	Amount	Total	Date	Amount
9/06	49' 6" PVC				
	1 ACx PVC Ferruco				
	1 Clean out @ Foundations				
6-5-70	EXIST AC.				



DATE _____

TOWN OF LEXINGTON — BOARD OF PUBLIC WORKS
SEWER DIVISION

Sketch of Service Here

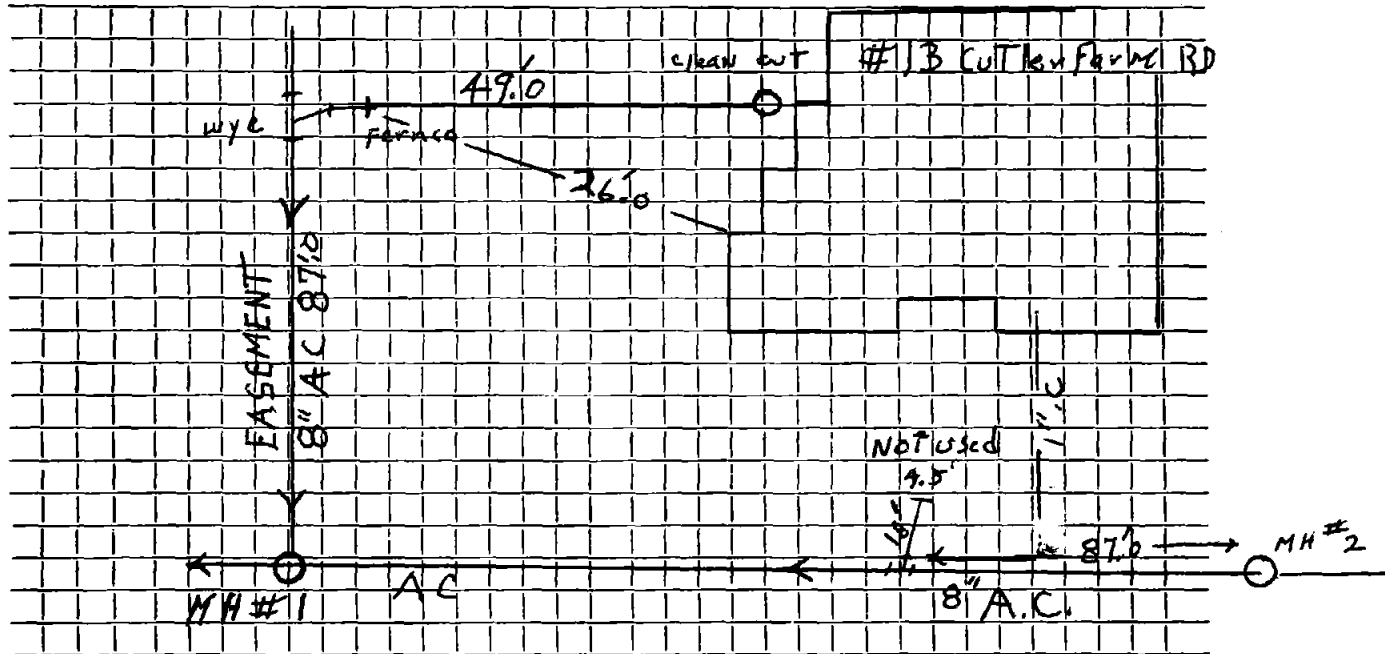

Connection made in Street. Work completed 9/06

Remarks:
.....
.....