

Name Kurt N. Reizes

Service No. 73

Address 14 Cutler Farm Road

Location

Kind of Pipe

Size

Size of Main

Repair—Renewal—New Service Valeri #1427

Location SEP 2 1969

Date		Material	Amount	Total	Date		Amount
7-29-64	21.5'	6" Transite pipe	@5.00	107.50	7-31-69	Deposit	107.50
8-5-69	35'	6" Transite pipe					
	10'	4" Cast Iron pipe					
11-19-92		Repair					
	8'	6" PVC					
	2	6" Ferncos					


DATE _____

TOWN OF LEXINGTON — BOARD OF PUBLIC WORKS

SEWER DIVISION

Sketch of Service Here

14

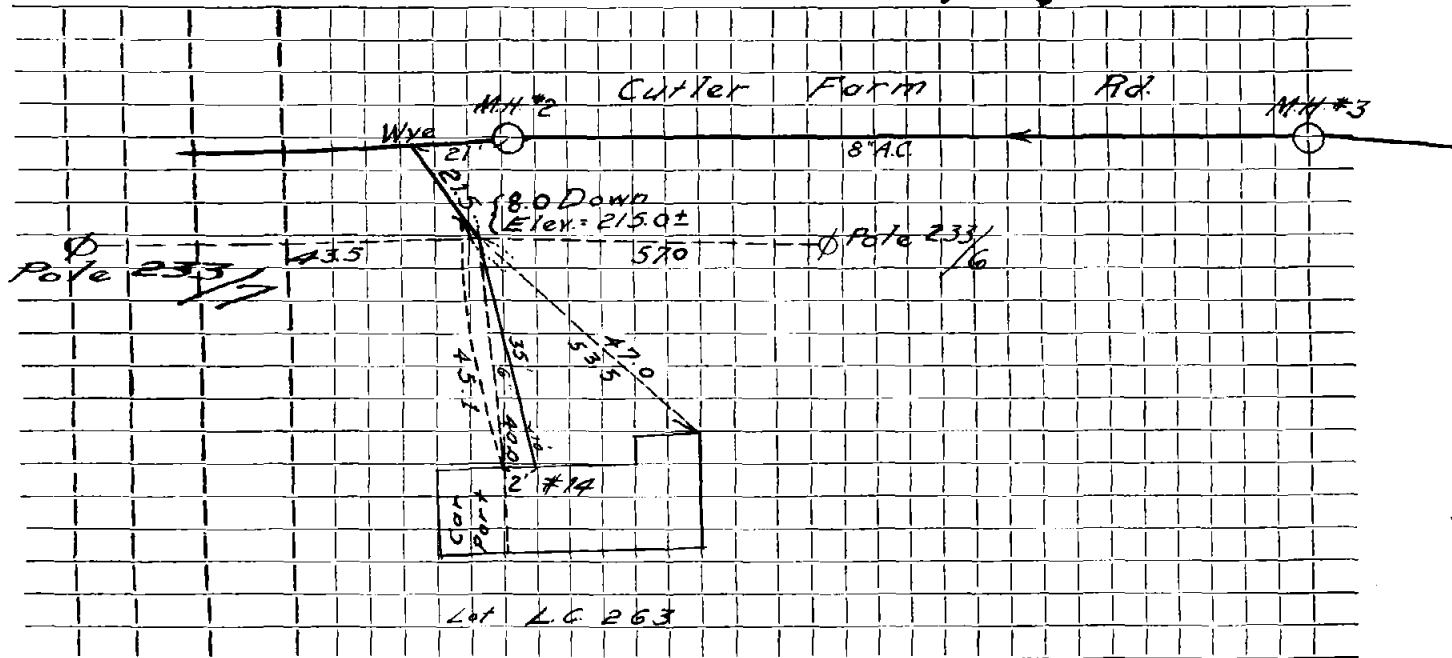

Connection made in _____ Street. Work completed _____

marks: _____

