

Name Anthony G. Johns

Service No. 86

Address 16 Cutler Farm Road

Location

Kind of Pipe

Size

Size of Main

Repair—Renewal—New Service

Lexington Sewerage #1717


Location DEC 31 1970

Date		Material	Amount	Total	Date		Amount
10-22-64	21'	6" Transite pipe @5.00 (connect to street) No charge to connect to easement		105.00	8-28-70	<i>Pipes it</i>	105.00
8/9/70	40'	6" Transite pipe					
	10'	4" Cast Iron pipe					

TOWN OF LEXINGTON — BOARD OF PUBLIC WORKS

SEWER DIVISION

Sketch of Service Here **16**

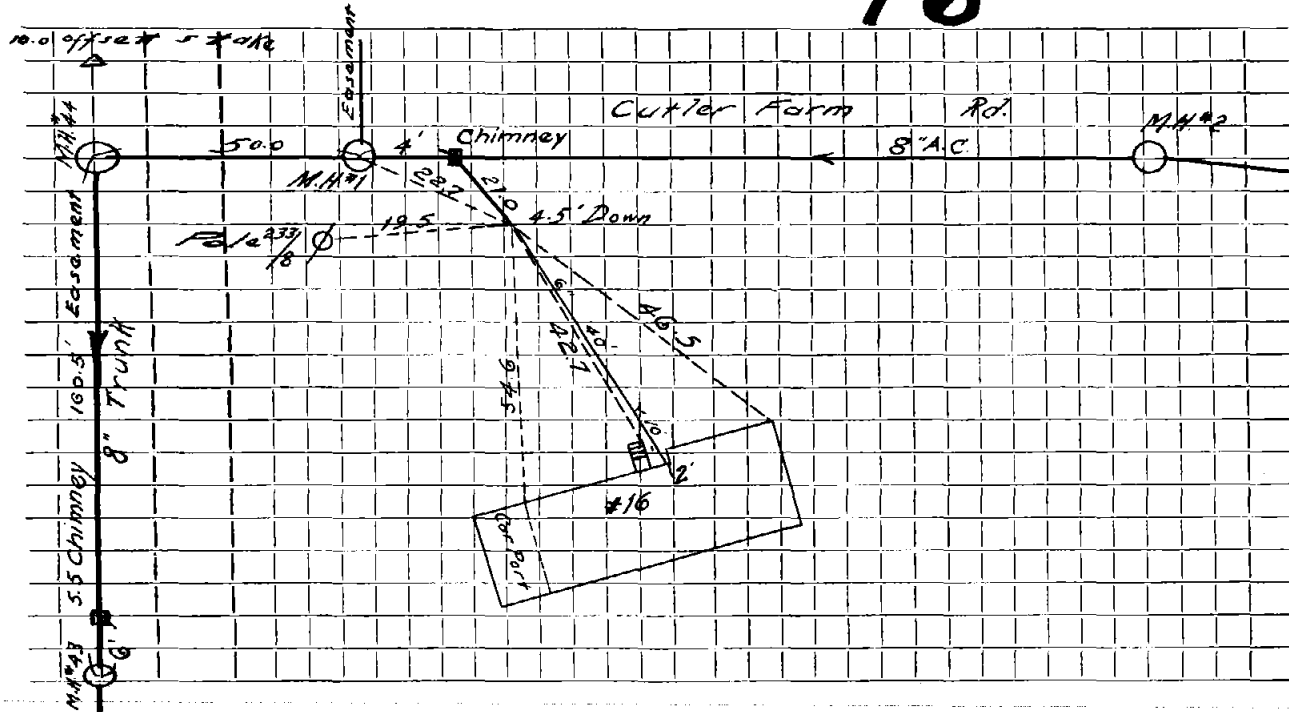

Connection made in Street. Work completed

Remarks:

Name **Anthony G. Johns**

Service No. **86**

Address **16 Cutler Farm Road**

Location

Kind of Pipe

Size

Size of Main

Repair—Renewal—New Service **Lexington Sewerage #1717**

Location **DEC 31 1970**

Date		Material	Amount	Total	Date	Amount
10-22-64	21'	6" Transite pipe @5.00 (connect to street) No charge to connect to easement		105.00	8-28-70	Deposit 165.00
8/9/70	40'	6" Transite pipe				
	10'	4" Cast Iron pipe				


DATE _____

TOWN OF LEXINGTON — BOARD OF PUBLIC WORKS

SEWER DIVISION

Sketch of Service Here

16

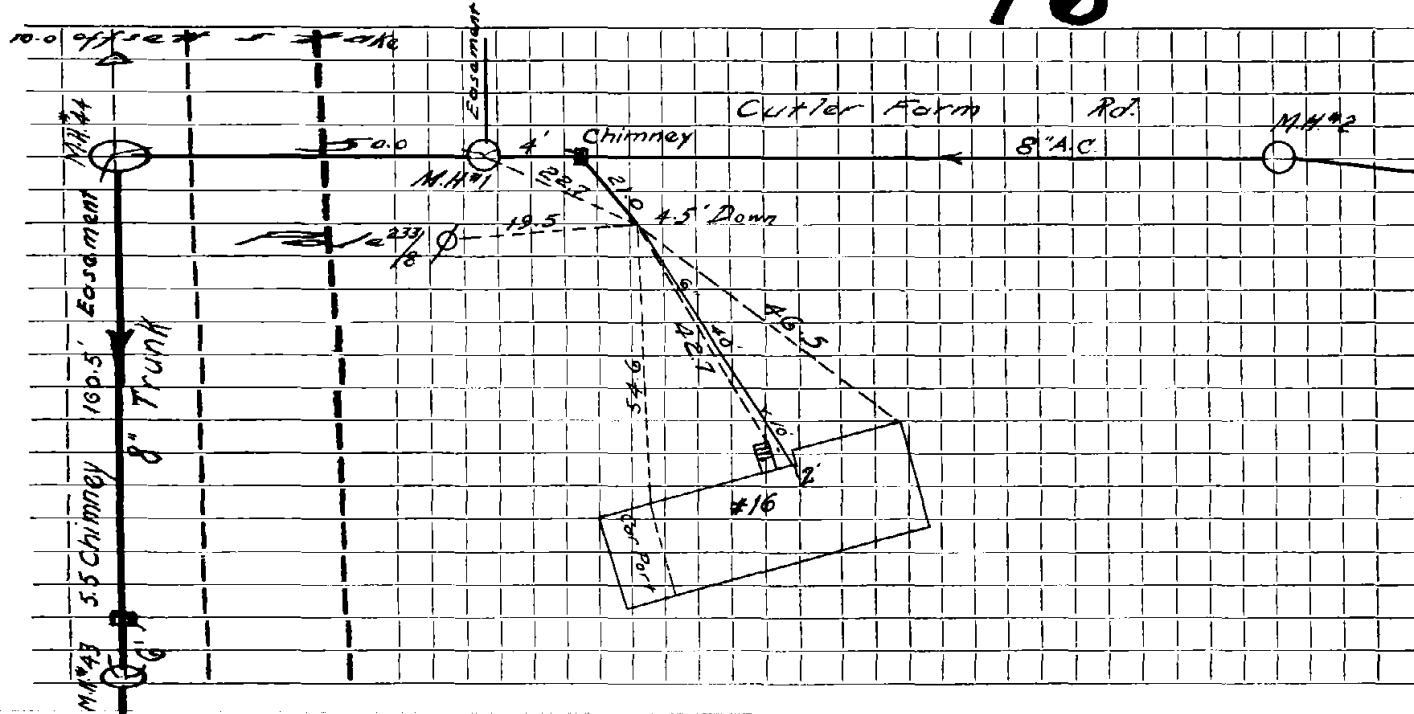

Section made in Street. Work completed

Remarks:

.....
.....