

Name Wesley S. Turner

Service No. 89

Address 2 Cuttler Farm Road

Location

Kind of Pipe

Size

Size of Main

~~Repair~~ ~~Renewal~~ **New Service**

John E. Grant Permit #378

Location AUG 9 1965


Date		Material	Amount	Total	Date	Amount
8-4-64	34'	6" Transite pipe @5.00		170.00	7-4-65	170.00
7-14-65	33'	6" Transite pipe				

DATE _____

TOWN OF LEXINGTON — BOARD OF PUBLIC WORKS

SEWER DIVISION

Sketch of Service Here **2**

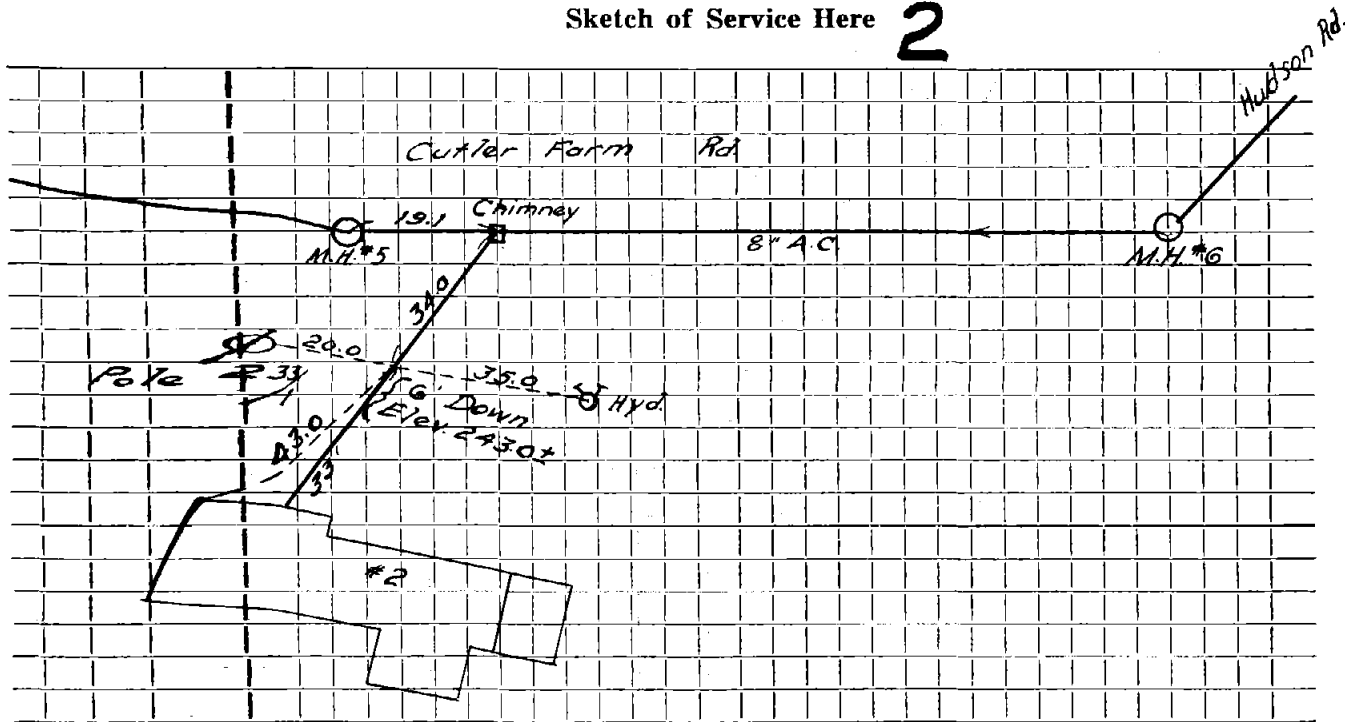

Connection made in Street. Work completed

Remarks:
.....
.....