

Name

Service No.

Address

~~25 Hudson Rd~~

New Address

3 Cutler Farm Rd.

Location

Kind of Pipe

Size

Size of Main

Repair—Renewal—New Service

Location

Date

Material

Amount

Total

Date

Amount

1.5.06

4X6 PVC to PVC Franco

8' - 4" PVC

48' - 6" PVC


2 - 6" 45° BENDS

1 - 6X6 PVC to AC Franco

DATE _____

TOWN OF LEXINGTON — BOARD OF PUBLIC WORKS
SEWER DIVISION

Sketch of Service Here

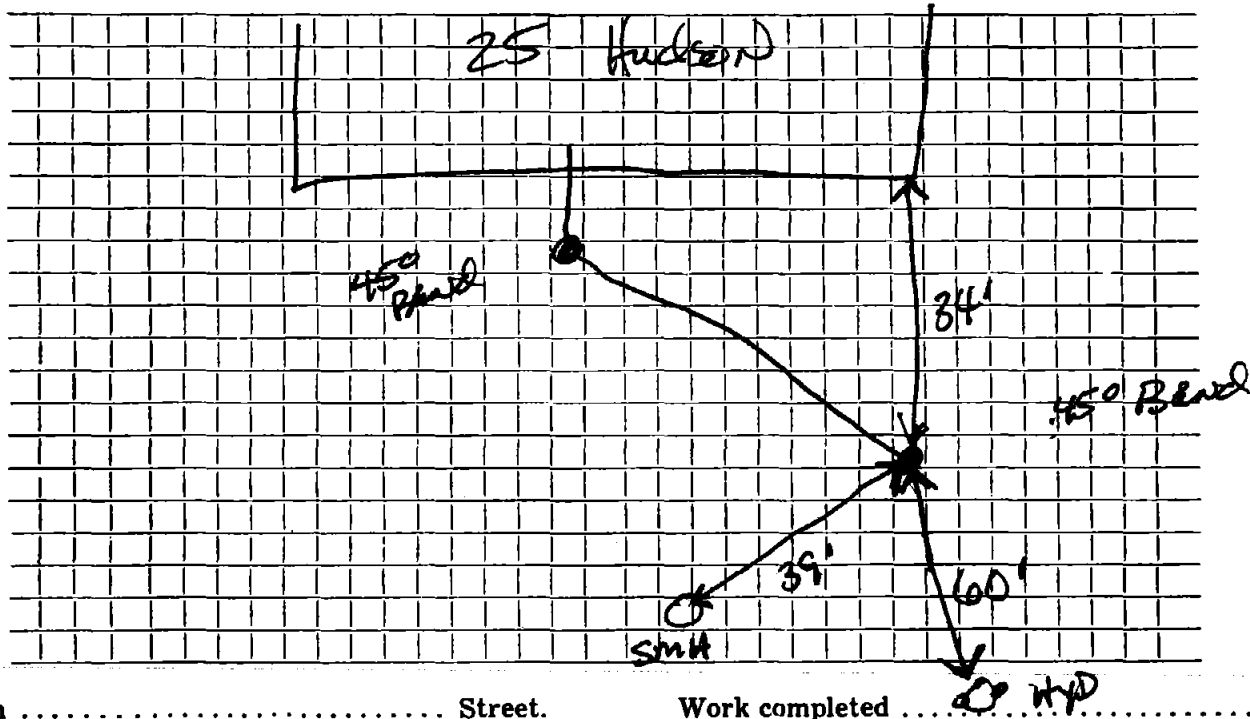

Connection made in Street. Work completed \odot HYD

Remarks:

service reviewed inside

wye ~~33'~~
33' 5" up from mt