
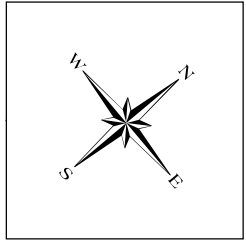


**Sewer Service Tie Card**  
**TOWN OF LEXINGTON**  
 MASSACHUSETTS

**5 Cutler Farm Road**

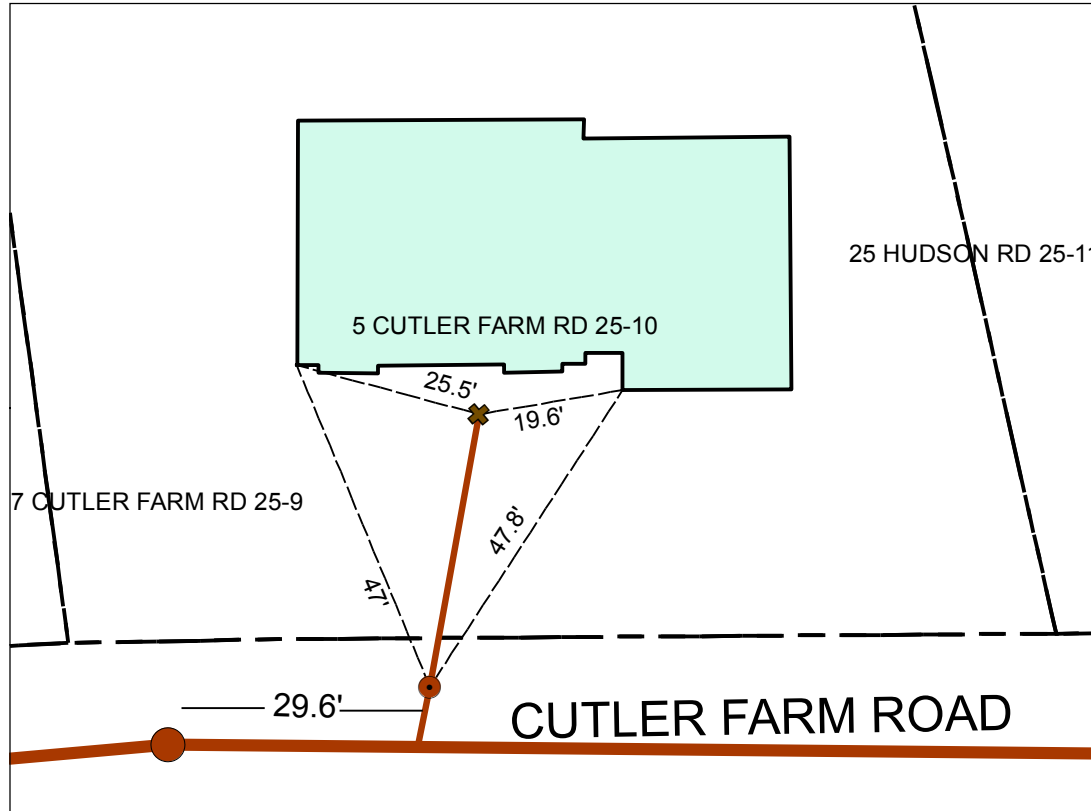

Legend	
<span style="color: orange;">●</span>	Sewer Manholes
<span style="color: orange;">+</span>	Sewer Service Clean Out
<span style="color: orange;">●</span>	Sewer Service Connection
- - -	Ties_Dimensions Sewer
<span style="color: orange;">—</span>	Sewer Service Line
<span style="color: orange;">—</span>	Sewer Main Line

Address	Map and Lot	Permit Number	Contractor Name	Inspector
5 Cutler Farm Road	25-10	5521	Santangelo	dpavlik

Date: 1/17/14	Material	Depth of Cover	Amount
	6x6 AC to PVC Fern Co	5.5 ft	Connect to existing stub
	6" PVC	7.5 ft	37.6 Feet to C.O.
	6"x4" Fern Co.	8 ft	Fern Co. at C.O.

Type of work completed

**New 6" PVC sewer service installed from old sewer connection. New house built, old house removed.**