


DATE 9-17-01

TOWN OF LEXINGTON — BOARD OF PUBLIC WORKS
SEWER DIVISION

Sketch of Service Here

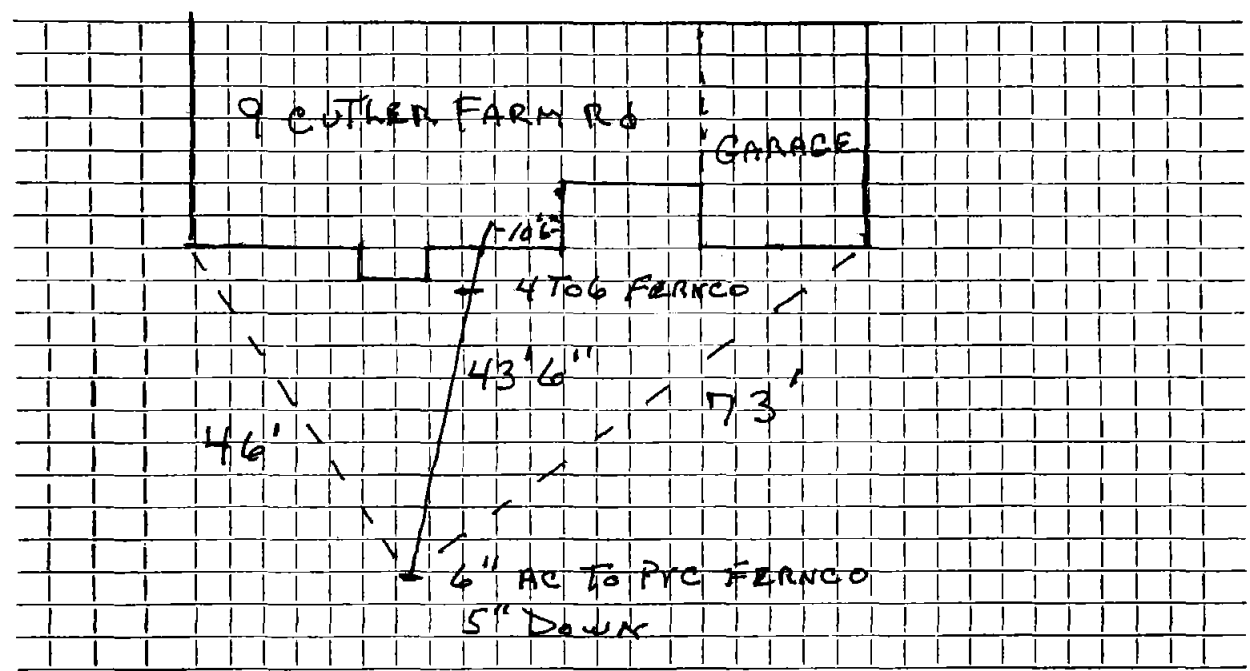

Connection made in CUTLER FARM RD. Street. Work completed

Remarks: J.M. McLAUGHLIN CONT.
.....
.....