

Name Louis Ciampa

Service No. 145

Address 16 Dane Road

Lot #212 Lot " 212

Location

Kind of Pipe

Size

Size of Main

~~Repair~~ ~~Renewal~~ - New Service

Location *Sum 12-31-58*

Date	Material	Amount	Total	Date		Amount
9-8-58	Labor	23.25		5-25-58	Deposit	5.00
	10% O.H.	2.33	25.58	12-31-58	Paid by W.P. ...	7.41
	45' 6" Transite pipe @.70		31.50	1-22-59	Paid	19.13
	1 6" Transite Bend		6.21			76.54
	1 Hr. Town Shovel @ 6.50		6.50			
	1 hr. Trucking @.75		.75			
	1 hr. Trucking @3.00		3.00			
	1 hr. Rodgers Trailer @ 3.00		3.00			
			76.54			
	Labor					

TOWN OF LEXINGTON—DEPT. OF PUBLIC WORKS

SEWER DIVISION

DATE

NO.

The undersigned applies for the construction of a particular sewer connecting No. Street and hereby agrees to comply with the Rules and Regulations governing the construction and use of Particular Sewers, as now or at any future time established by the Board of Selectmen.

Am't of estimate \$.....


Am't Paid \$.....

..... Owner

Sewer & Water in Same Trench

Sketch of Service Here

16

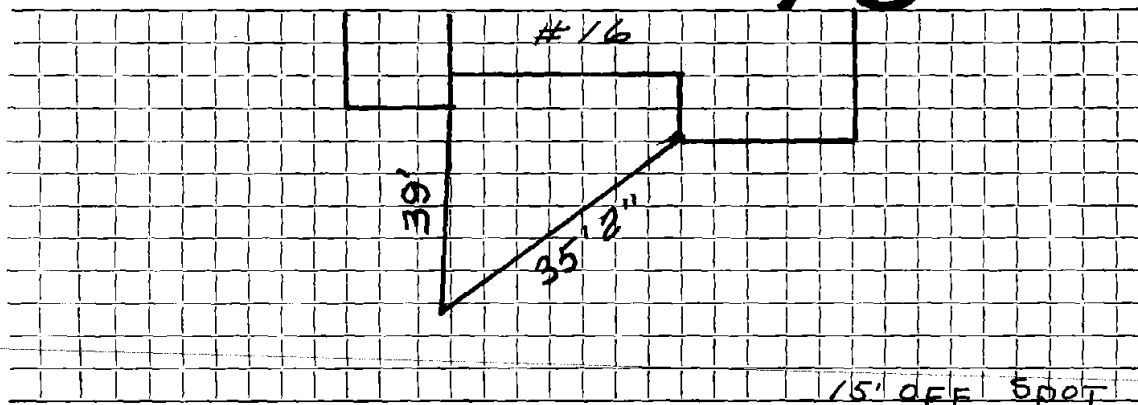

Connection made in Street.

Work completed 19..

Remarks: