


DATE 10/4/19

TOWN OF LEXINGTON — BOARD OF PUBLIC WORKS
SEWER DIVISION

Sketch of Service Here

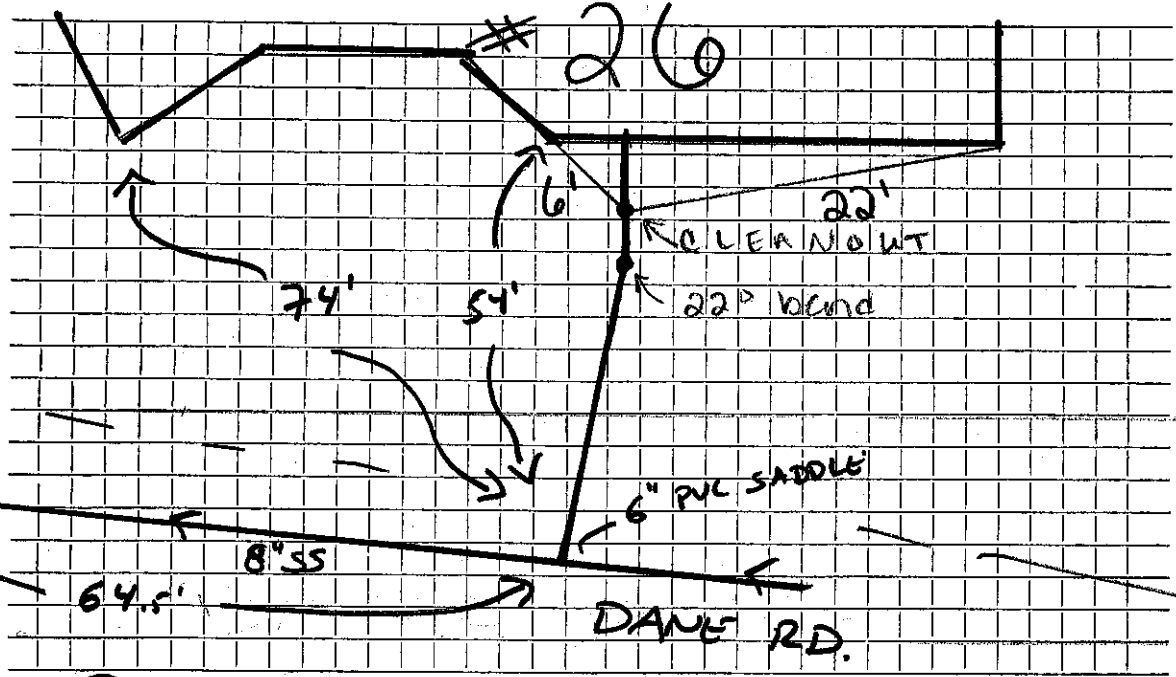

on made in DANE RD Street. Work completed