

Name Harry Johnson

Paid By Eric G. Sahlberg
7 Frost St., Camb)

Service No. 15 218

Address 50 Brighton Street

#10

Belmont, Mass.

Location Lot 15 Daniels Street

Kind of Pipe

Size

Size of Main

Repair—Renewal—New Service

Location

Date
1938

Material

Amount

Total

Date

Amount

5/27/38

2 hrs. @ 60¢

1 20

June 1, 1938 Deposited

31 00

Com 7-5-38

33' 6" Sewer Pipe @ 20¢

6 60

Jointing Compound

2 04

2 hrs. Trucking @ 75¢

1 50

11 34

Flat Rate

\$31 00

Labor

TOWN OF LEXINGTON—BOARD OF PUBLIC WORKS

SEWER DIVISION

DATE July 9-37

NO. _____

The undersigned applies for the construction of a particular sewer connecting No. Lot 15 Daniels St Street and hereby agrees to comply with the Rules and Regulations governing the construction and use of Particular Sewers, as now or at any future time established by the Board of Selectmen.


Am't. of Estimate \$ _____

Am't. Paid \$ _____

16 DANIELS

Harry O Johnson Owner
by Gertrude Sakberg

Sketch of Service Here

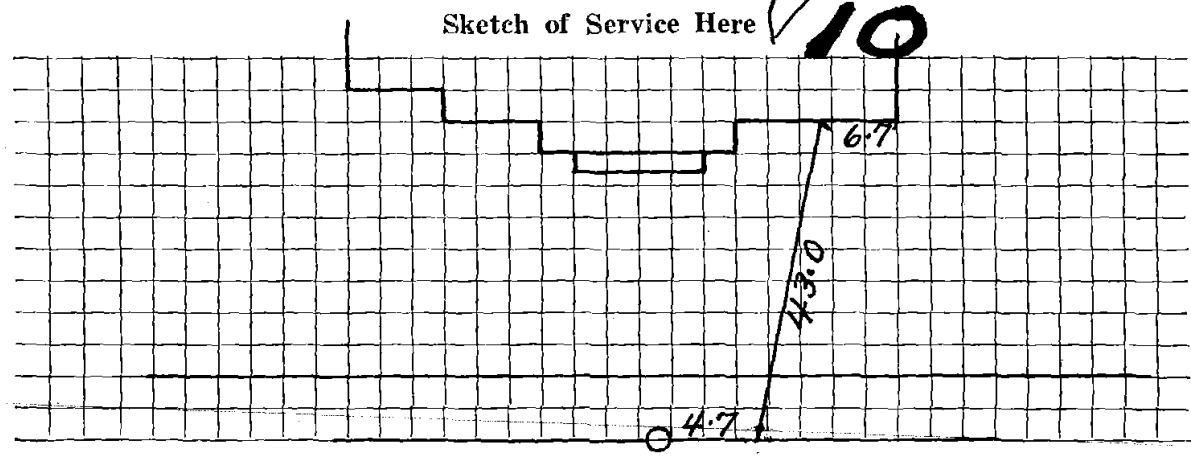

Connection made in _____ Street.

Work completed _____ 19

Remarks: