

Name Harry Johnson Check from Eric G. Sahlberg
 Address 50 Brighton Street
 Belmont, Mass.

Service No. 219

Location Lot 16 Daniels Street (#12)

Kind of Pipe Size Size of Main

Repair—Renewal—New Service

Location

Date 1938	Material	Amount	Total	Date	Amount
5/19/38	27 hrs. @ 50¢	13 50		May 12, 1938	43 50
<i>Jan 7-5-38</i>	59 " @ 55¢	32 45		Deposited	
	7 " @ 60¢	4 20			
	9 " @ 65¢	5 85			
	7 " @ 70¢	4 90	60 90		
	10% Overhead		6 09		
	42' 6" Sewer Pipe @ 20¢		8 40		
	1 6 x 4 Reducer		1 00		
	Joint Compound		2 52		
	Compressor- 3 hrs. @ 3.00		9 00		
	Trucking- 2 hrs. @ 75¢		1 50		
			<u>89 41</u>		
	Destac Charge \$43.50				

Hadley Press, Inc., Lexington

TOWN OF LEXINGTON—BOARD OF PUBLIC WORKS
SEWER DIVISION

DATE July 9-97

NO. _____

The undersigned applies for the construction of a particular sewer connecting No. 12 Daniels St Street and hereby agrees to comply with the Rules and Regulations governing the construction and use of Particular Sewers, as now or at any future time established by the Board of Selectmen.

Am't. of Estimate \$ 13,000


Am't. Paid \$ _____

Nancy E Johnson Owner
by Fred C. Solbey

12 DANIELS

Sketch of Service Here

12

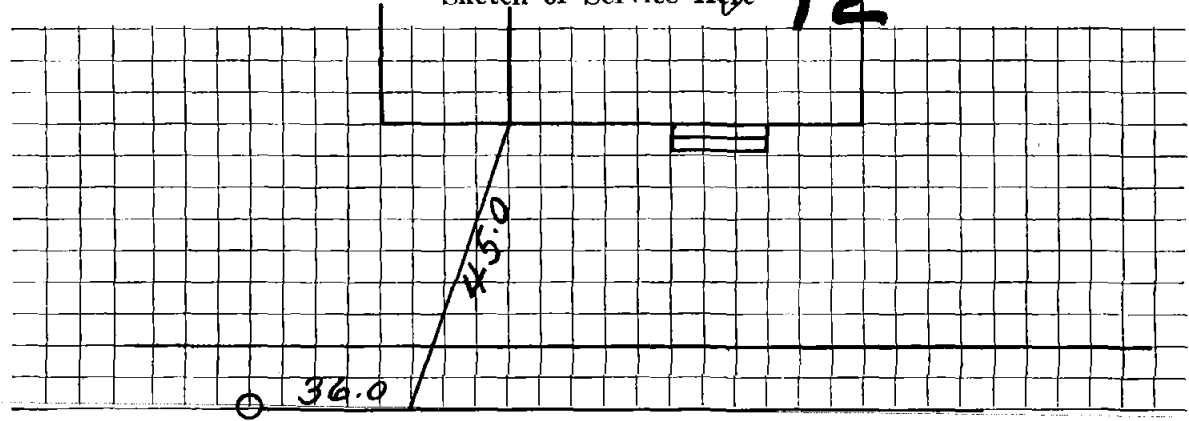

Connection made in _____ Street.

Work completed _____ 19

Remarks: