

Name James Gaudet
 Address 76 Endicott Avenue, Somerville

Service No. 16 214

Location #3 Daniels Street

Kind of Pipe

Size

Size of Main

Repair—Renewal—New Service

Location

Date	Material	Amount	Total	Date	Amount
1938 June 8, <i>Sum 7-17-38</i>	2 hrs. @ 60¢	1 20	1 20	May 31, 1938	30 00
	22' 6" Sewer Pipe @ 20¢		4 40	July 15, 1938	14 00
	Jointing compound		1 32		16 00
	Trucking 2 hrs. @ 75¢		1 50		
			8 42		
	Flat Rate: \$16.00				
	Labor				

Deposited
Refunded

* Refund of \$14.00 to be made payable to credit to Water Connection acc't #24. Town,

Hadley Press, Inc., Lexington

TOWN OF LEXINGTON—BOARD OF PUBLIC WORKS
SEWER DIVISION

DATE _____

NO. _____


The undersigned applies for the construction of a particular sewer connecting No. No 3 Daniels St Street and hereby agrees to comply with the Rules and Regulations governing the construction and use of Particular Sewers, as now or at any future time established by the Board of Selectmen.

Am't. of Estimate \$ _____

Am't. Paid \$ _____

James Gaudet Owner

Sketch of Service Here

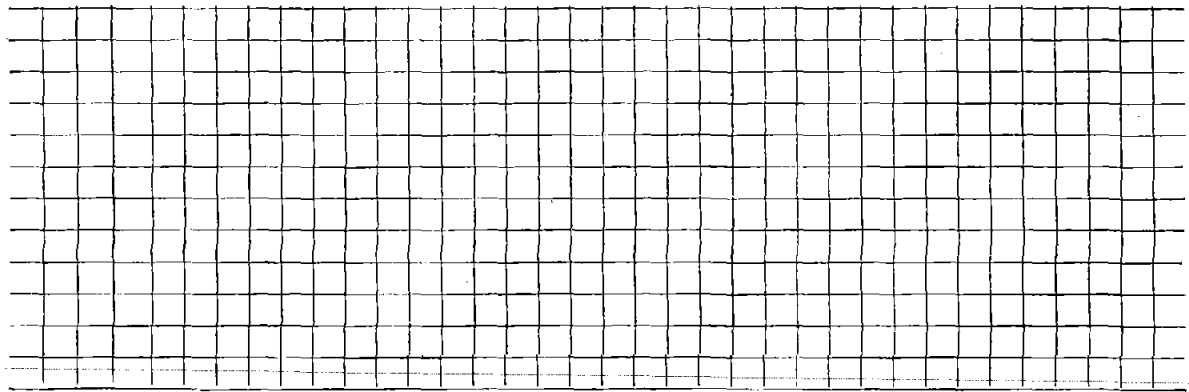

Connection made in _____ Street.

Work completed _____ 19

Remarks:

