

Name

Service No.

Address

4 Daniels Street

Location

Kind of Pipe

Size

Size of Main

Repair—Renewal—New Service

Location


Date	Material	Amount	Total	Date	Amount
10-26-37					
	66' 6" Sewer Pipe				
12-12-66	RENEWAL				
	18' 6" Pipe				
	1 6" Adapter				
				3-24-66	ROOTS
				4-19-64	ROOTS

DATE _____

TOWN OF LEXINGTON — BOARD OF PUBLIC WORKS

SEWER DIVISION

Sketch of Service Here **4**

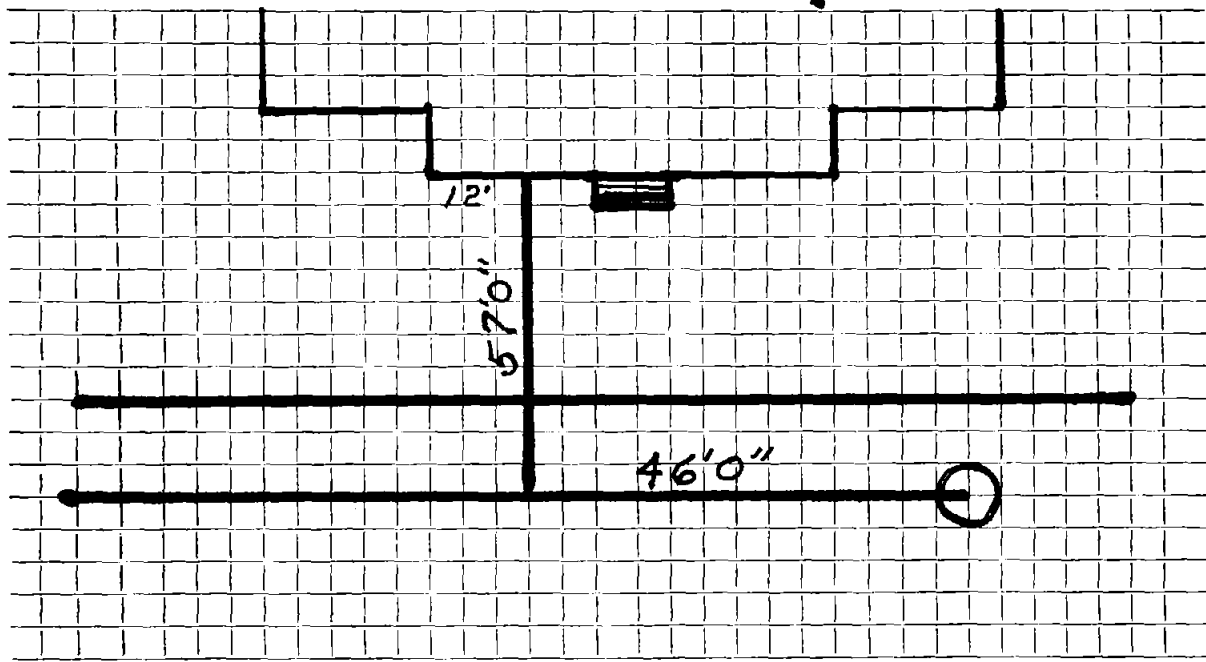

Connection made in Street. Work completed

Remarks:
.....
.....