

Name Eric G. Bahlberg

Service No. 26 216

Address 176 Upland Road

Cambridge, Mass.

Location Lot 13 Daniels Street

Kind of Pipe

Size

Size of Main

Repair—Renewal—New Service

58' @ 65¢ - \$38.00

Location

Date	Material	Amount	Total	Date	Amount
1937					
Oct. 16	2 hrs. @ 50¢	1 00		Oct 13, 1937	38 00
	2 " @ 55¢	1 10		Deposited	
	4 " @ 60¢	2 40			
	2 " @ 70¢	1 40	5 90		
	10 % overhead		59		
	58' @ 6" Sewer Pipe @ 25¢		14 50		
	Jointing Compound		2 90		
			23 89		
	Flat Rate:				
	58' @ 65¢		\$38 00		
	Labor				

Hadley Press, Inc., Lexington

TOWN OF LEXINGTON—BOARD OF PUBLIC WORKS  
SEWER DIVISION

DATE July 9-37

NO. \_\_\_\_\_


The undersigned applies for the construction of a particular sewer connecting No. Lot 13 Daniels St  
Street and hereby agrees to comply with the Rules and Regulations governing the construction and use of Particular  
Sewers, as now or at any future time established by the Board of Selectmen.

Am't. of Estimate \$ \_\_\_\_\_

Am't. Paid \$ \_\_\_\_\_

Eric H. Salberg Owner

6 DANIELS

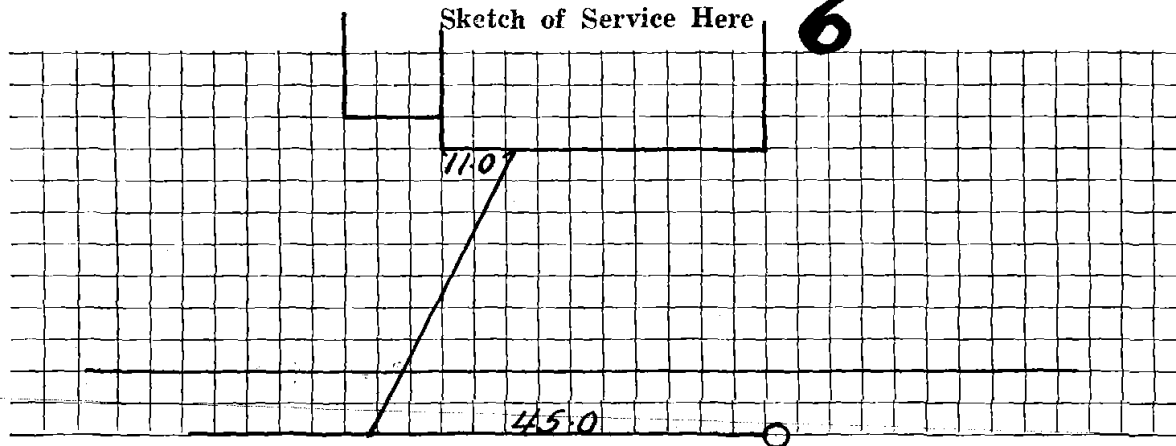

Connection made in \_\_\_\_\_ Street.

Work completed \_\_\_\_\_ 19

Remarks: