


DATE _____

TOWN OF LEXINGTON — BOARD OF PUBLIC WORKS

SEWER DIVISION

Sketch of Service Here

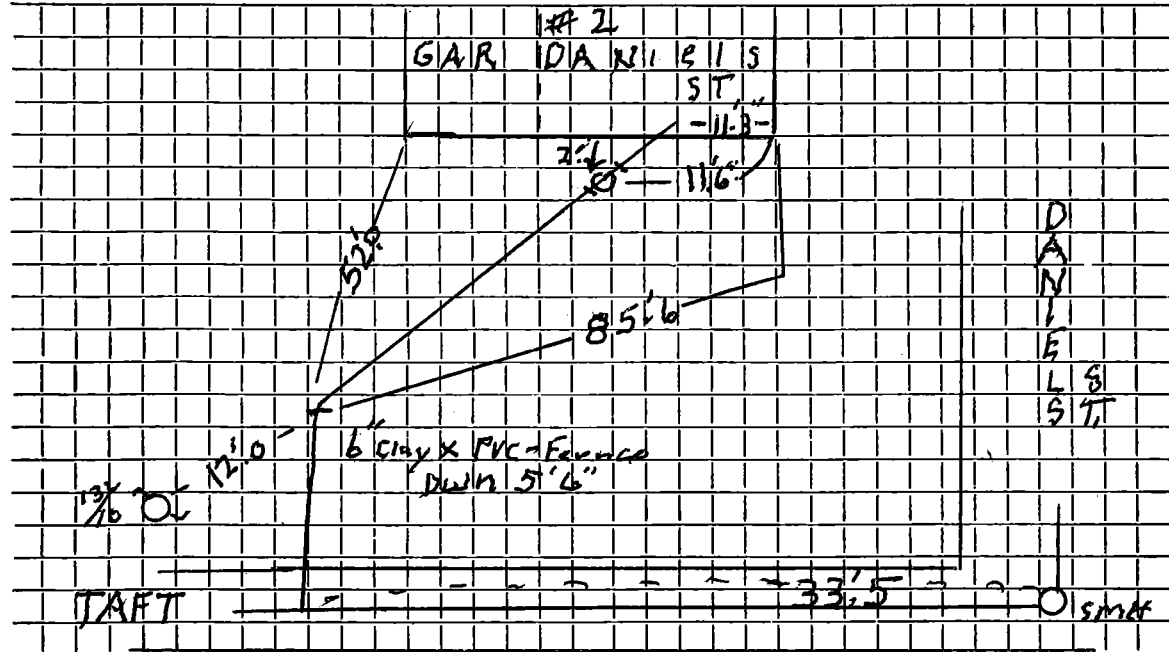

Connection made in Taft Ave Street. Work completed 9/26/2011 J. Mel.

Remarks:
.....
.....