

Name Benjamin J. Mayo, Jr.

Service No. 99

Address 11 Dawes Road

Location

Kind of Pipe

Size

Size of Main

~~Repair~~ ~~Renewal~~ ~~New Service~~

Lexington Landscape Permit #388

Location

AUG 9 1965


Date	Material	Amount	Total	Date	Amount
	34' 6" Transite pipe @7.00		238.00	7-16-65	4.51
	29' 6" Transite pipe @7.00		203.00		
7-28-65	47' 6" Transite pipe				
	SECOND SERVICE (McKee #4398)				
6/15/87	88' 6" P.V.C.				
	4 x 6 Donut				
	3 45° 6" Coup.				
	1 6" Wye				
	1 22° Coup.				
	1 6 x 6 Fernco P.V.C. to A.C.				

DATE _____

TOWN OF LEXINGTON — BOARD OF PUBLIC WORKS

SEWER DIVISION

Sketch of Service Here **11**

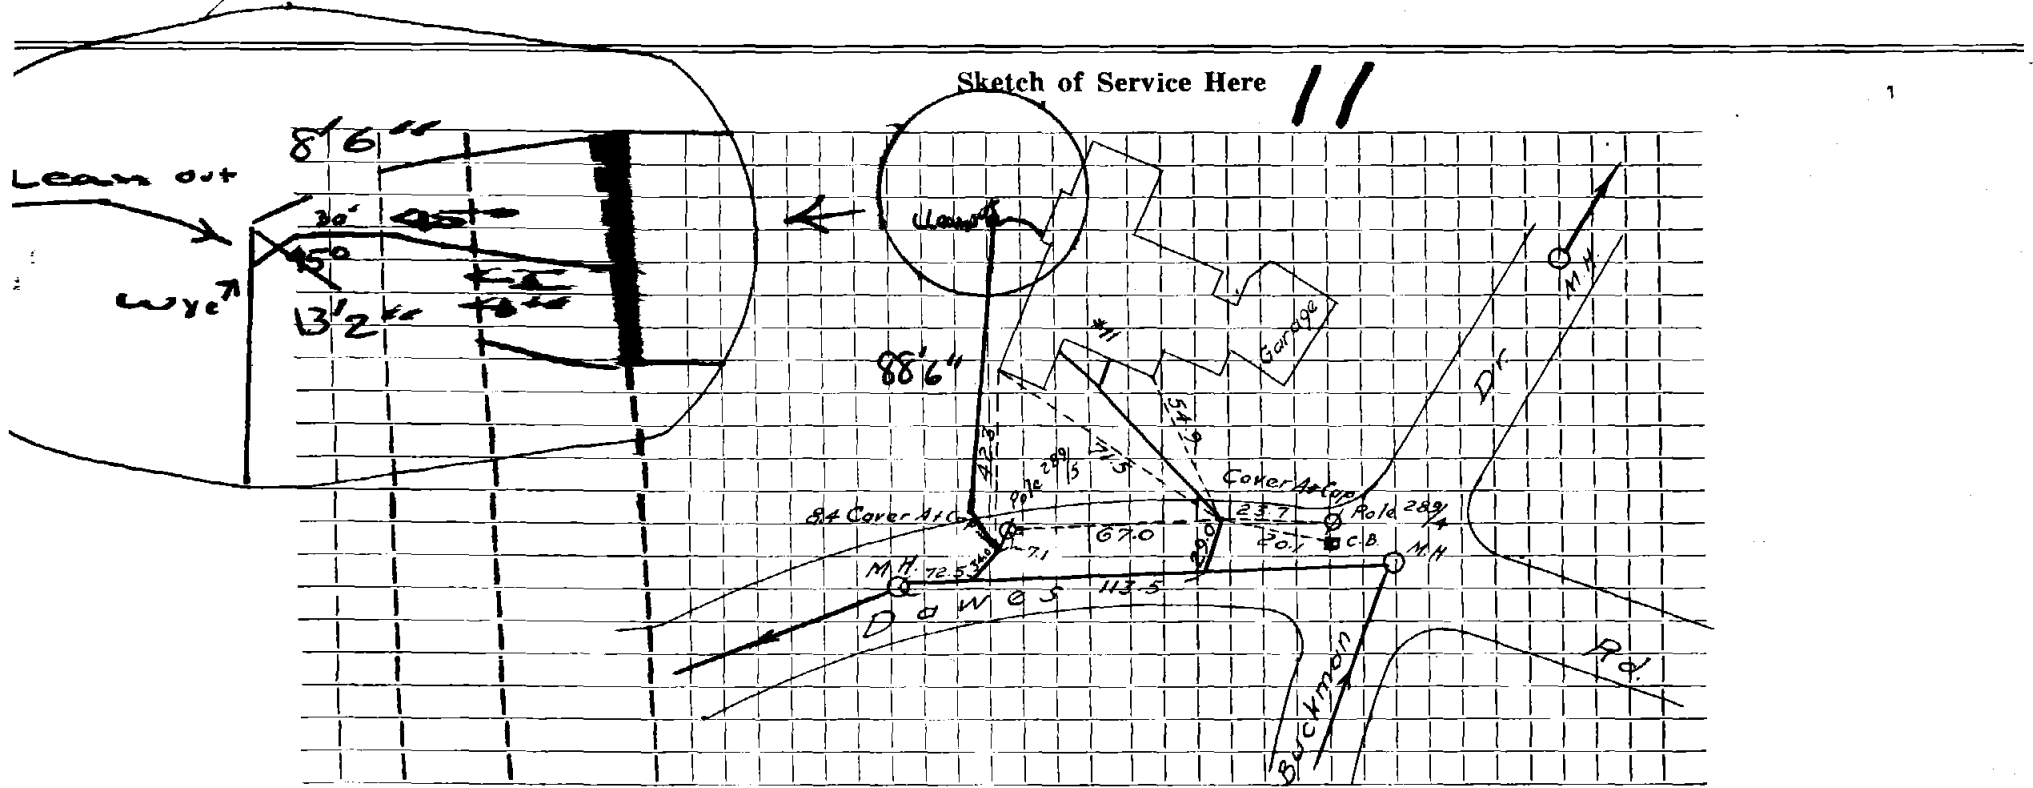

Section made in _____ Street. Work completed 19 to 20' off Tele. pole
 289
 5 ELEG and Tele
 in sewer trench
 2 1/2 Deep