

Name John Heitman

Service No. 5

Address 12 DAVIS RD.

Location

Kind of Pipe AC

Size 6"

Size of Main 8"

~~Repair - Renewal~~ New Service Valeri #4315


Location SEP 5 1986

Date	Material	Amount	Total	Date	Amount
1-2-80	16' 6" ACP	15.00	= \$240.00	4-10-80	Deposit
4/10/86	31' x 6" PVC Pipe				240.00
	1 4" x 6" Fernco Adaptor			1-2-80	
	1 6" PVC Coupling			16' 6" ACP	
	1 6" PVC x ACP Adaptor				

DATE _____

TOWN OF LEXINGTON — BOARD OF PUBLIC WORKS
SEWER DIVISION

Sketch of Service Here **12**

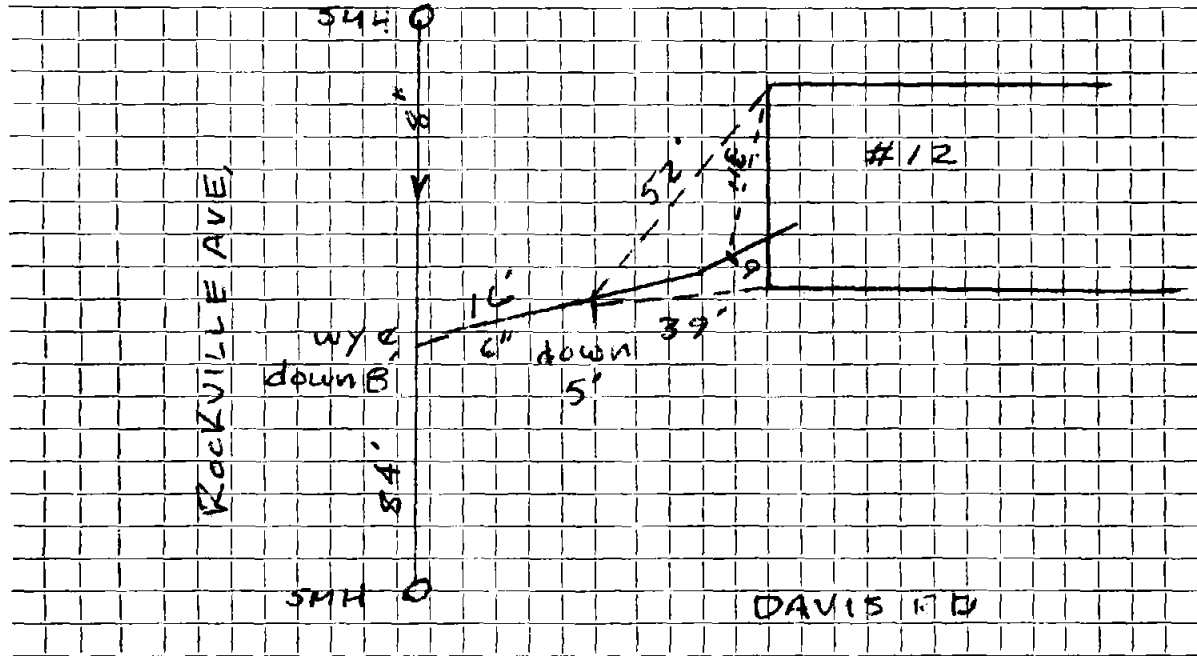

Connection made in Rockville Ave, Street. Work completed 4-10-86

Remarks:

.....

.....