

Name John F. Hayden

Service No. 55

Address 4 Davis Rd.

Location

Kind of Pipe AC

Size 6"

Size of Main 8"

Repair—Renewal—New Service

Suburbanite Cesspool Service #2521

Location AUG 16 1976

Date	Material	Amount	Total	Date	Amount
8-20-74	20' - 6" AC	208 7.00	140.00	9/20/74	Deposit 140.00
9/9/74	57' 6" Transite Pipe				
	16' 4" Cast Iron Pipe			8-20-74	
				20' 6" AC	

DATE _____


TOWN OF LEXINGTON — BOARD OF PUBLIC WORKS

SEWER DIVISION

Sketch of Service Here

4

Exist. SMH @ Moreland Ave

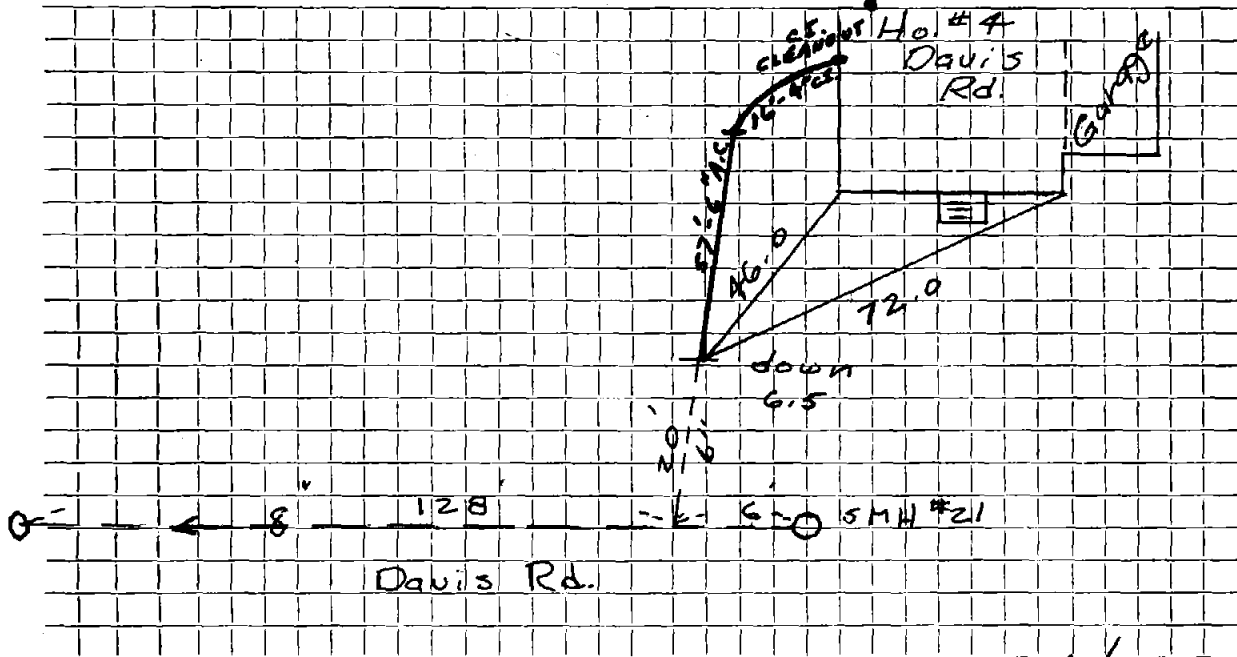

Connection made in Davis Rd. Street.

Work completed 9/9/74

Remarks:

.....

.....