

Name L.H. Hewett, Jr., Inc.

Service No. 82

Address 5 Davis Road

Location

Kind of Pipe

Size

Size of Main

~~Repair - Renewal~~ New Service Hewett #3497 Great Northern

Location

Date	Material	Amount	Total	Date	Amount
6-24-80	33' 6" Transite pipe @	15.00	495.00	10-20-79	1200.00
6-23-80	40' 6" Transite			7-2-80	705.00
	10' 4" Cast Iron				425.00
				6-24-80	
				33' 6" Transite	




DATE _____

TOWN OF LEXINGTON — BOARD OF PUBLIC WORKS

SEWER DIVISION

Sketch of Service Here **5**

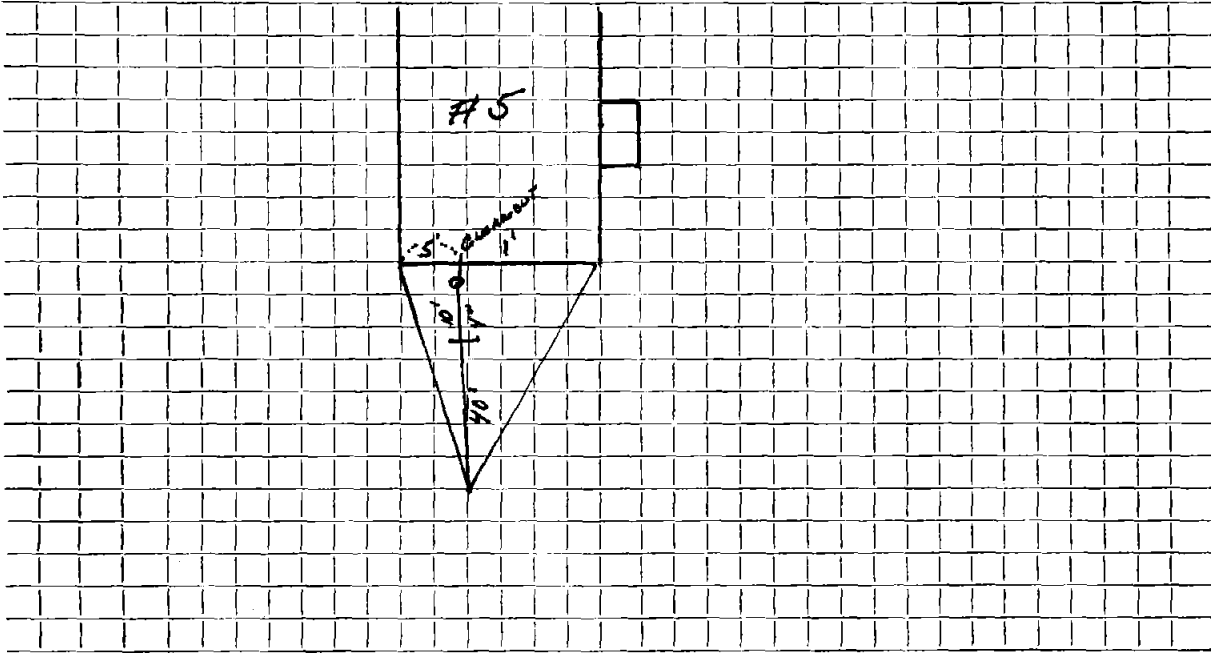

Connection made in Street. Work completed

Remarks:
.....
.....