

Name Paul Black

Service No. 76

Address 21 Dawes Road

Location

Kind of Pipe

Size

Size of Main

Repair—Renewal—New Service Trebing #3105


Location NOV 19 1973

Date	Material	Amount	Total	Date	Amount
<del>1965</del>	<del>16"</del> Transite pipe @7.00 installed by contractor		112 00	<del>7-30-73</del>	Deposit 112 00
8/3/73	134' 6" Transite pipe			1965	
				16' 6" TRANSITE	

**TOWN OF LEXINGTON — BOARD OF PUBLIC WORKS**  
**SEWER DIVISION**

Sketch of Service Here

**21**

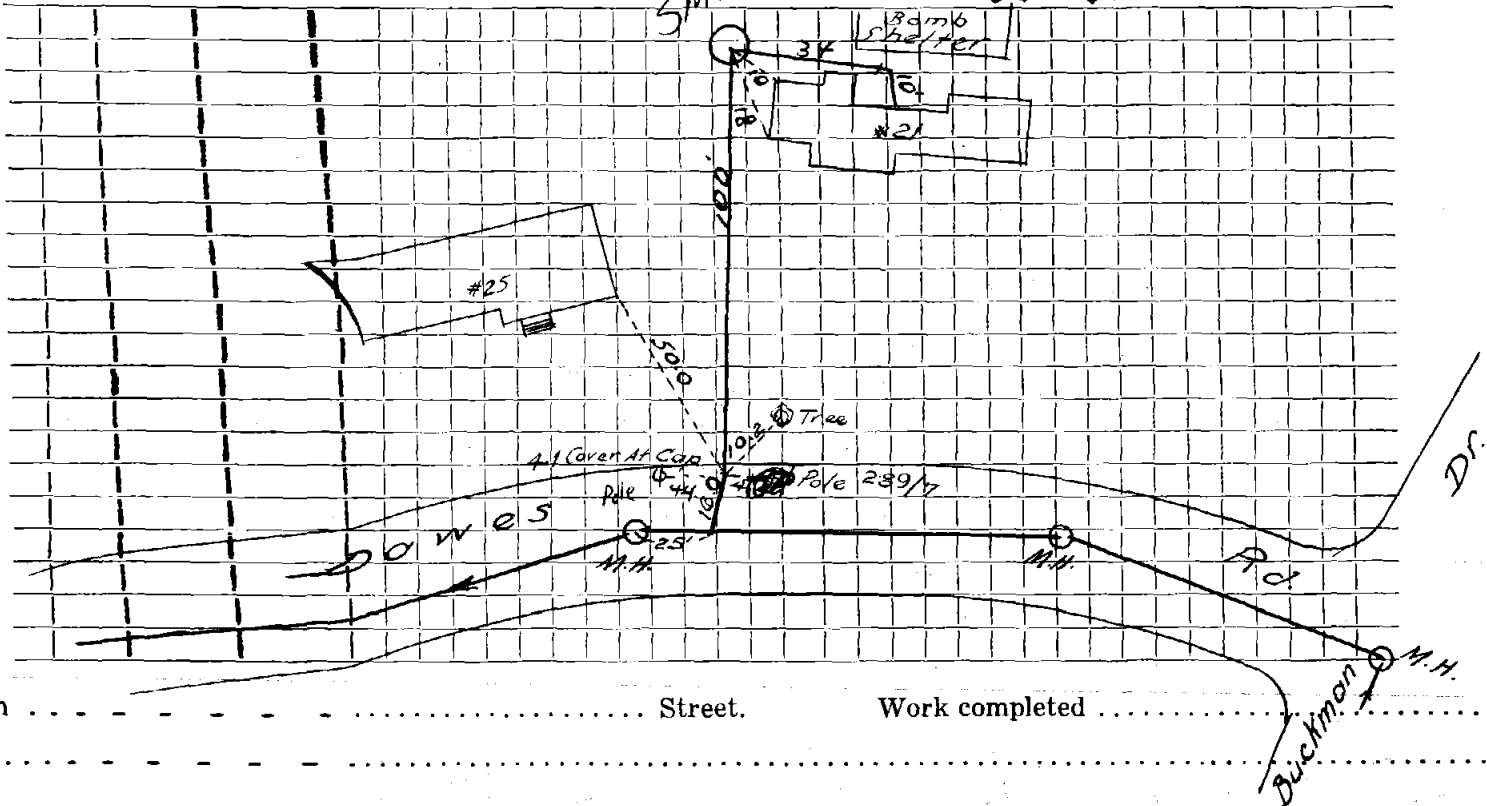

Connection made in ..... Street.      Work completed .....

Remarks: .....

.....

.....