

Name Harold Frye

Service No. 195

Address 24 Dawes Road

Location

Kind of Pipe

Size

Size of Main

Repair—Renewal—New Service Valeri #937

Location MAY 13 1968

Date

Material

Amount

Total

Date

Amount


1965	17'	Transite pipe @7.00		119 00	12-22-67	<i>Deposit</i>		119 00
		installed by contractor						

12-27-67	90'	6" Transite pipe			1965			
	10'	4" Cast Iron pipe			17'	6" Transite		

DATE _____

TOWN OF LEXINGTON — BOARD OF PUBLIC WORKS
SEWER DIVISION

Sketch of Service Here **24**

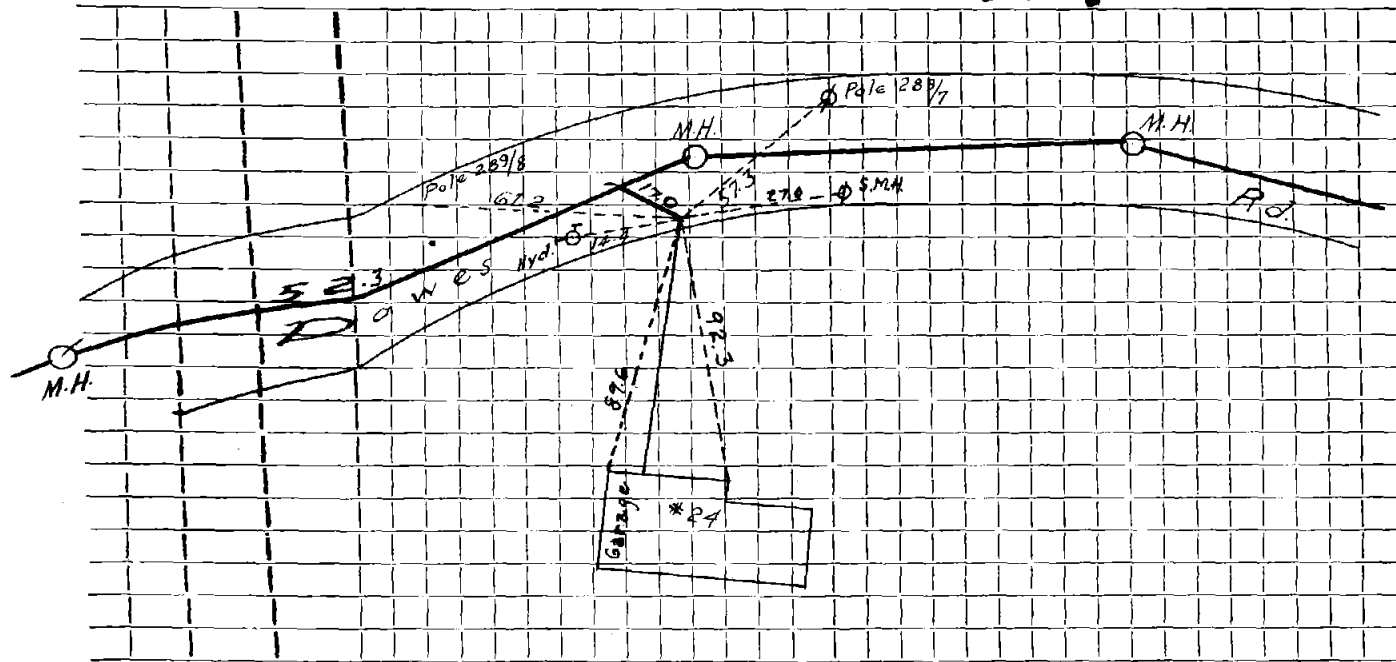

Connection made in Street. Work completed

Remarks:
.....
.....