

Name

Service No.

Address 25 Dawes Road

Location

Kind of Pipe

Size

Size of Main

Repair—Renewal—New Service

Location

Date

Material

Amount

Total

Date

Amount

~~1965~~

~~26'~~

~~Transite pipe @7.00~~

182 00

installed by contractor

1965


26' 6" Transite

DATE _____

TOWN OF LEXINGTON — BOARD OF PUBLIC WORKS

SEWER DIVISION

Sketch of Service Here **25**

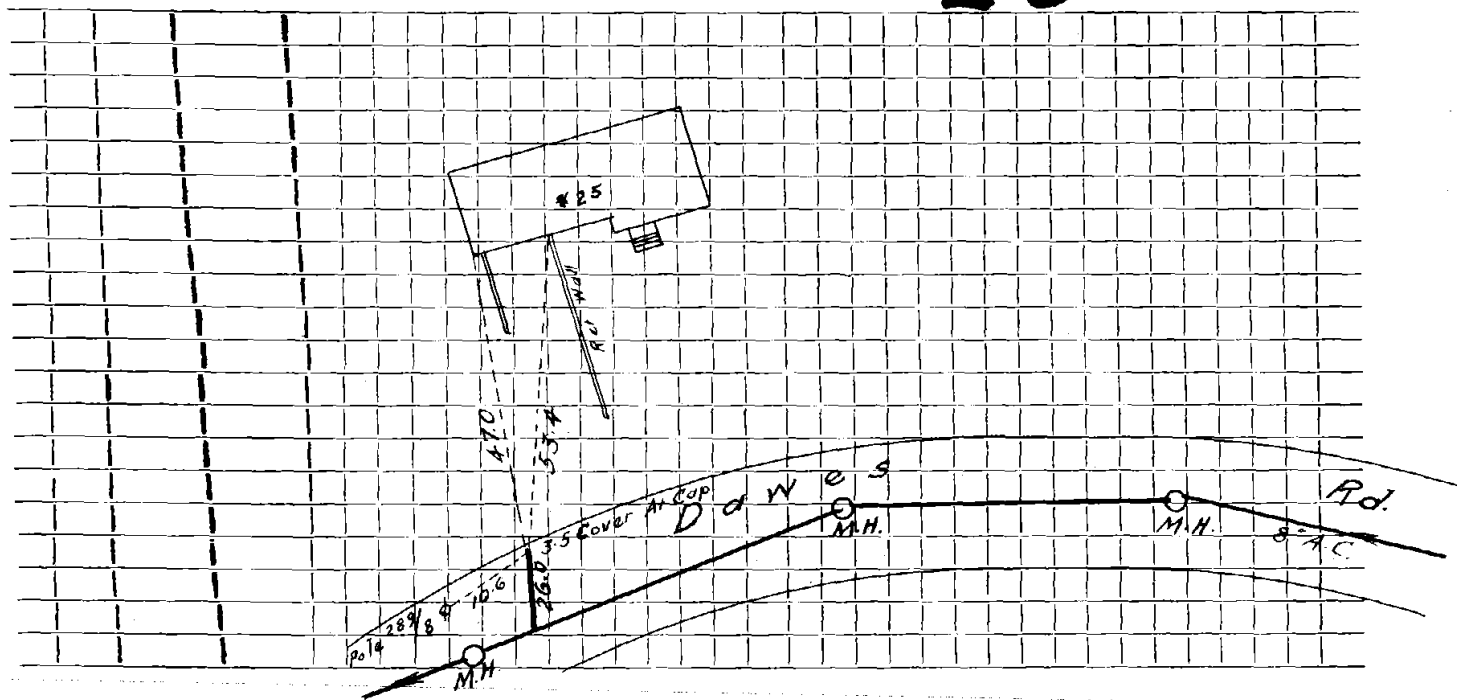

Connection made in Street. Work completed

Remarks: