

Name

Service No.

Address 29 Dawes Road

Location

Kind of Pipe

Size

Size of Main

Repair—Renewal—New Service

Location

Date

Material

Amount

Total

Date

Amount

~~1965~~ 38' Transite pipe @7.00  
installed by contractor

266 00

1965


38' 6" Transite

DATE \_\_\_\_\_

# TOWN OF LEXINGTON — BOARD OF PUBLIC WORKS

## SEWER DIVISION

Sketch of Service Here **29**

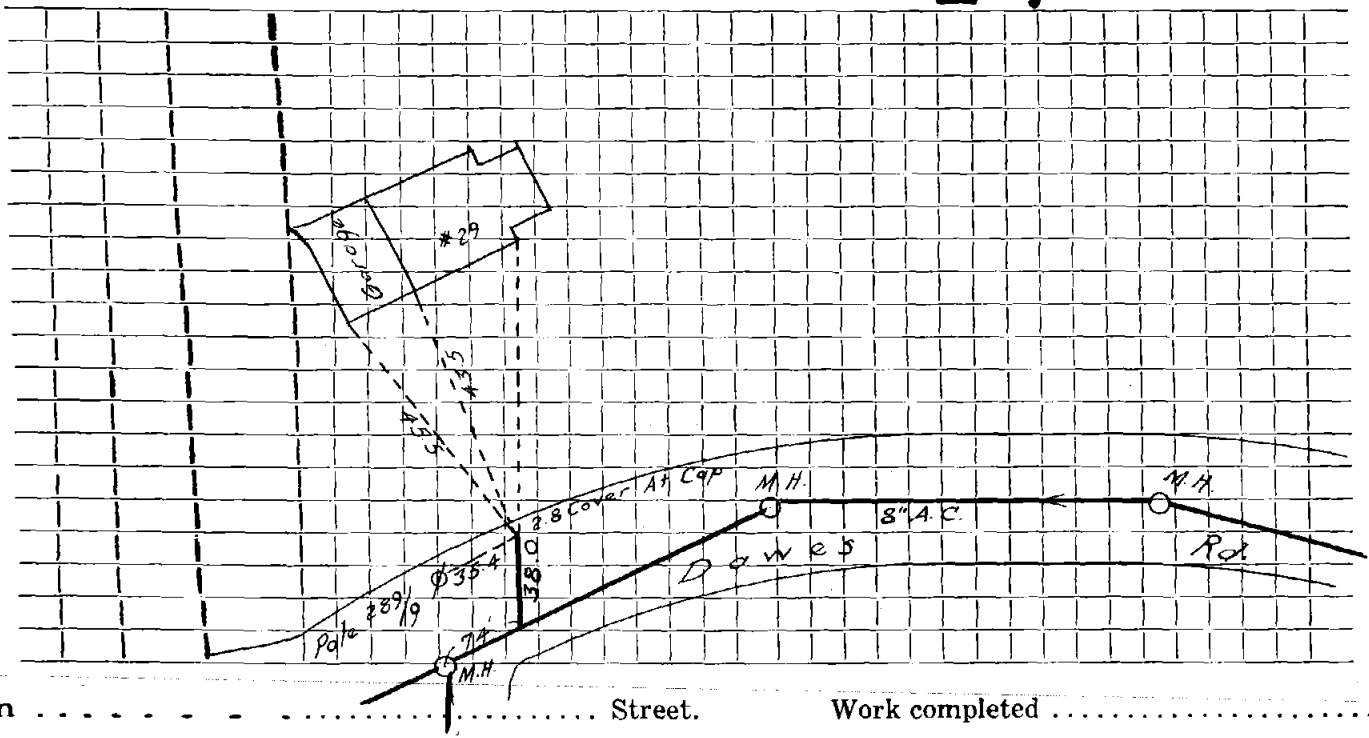

Connection made in ..... Street. Work completed .....

Remarks: .....