


DATE _____

TOWN OF LEXINGTON — BOARD OF PUBLIC WORKS

SEWER DIVISION

Sketch of Service Here

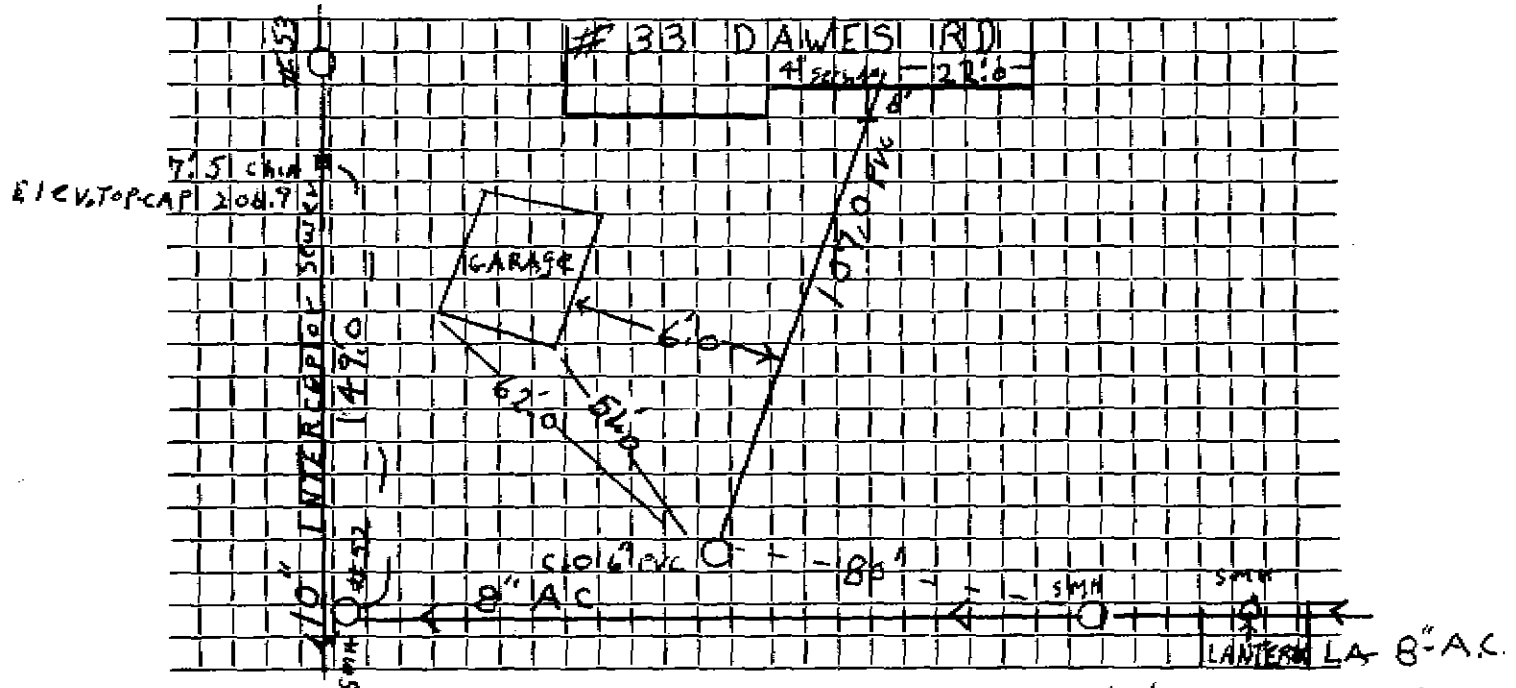

Connection made in _____ Street.

Work completed 12/1/08 J. K. Laughlin.

Remarks: NO INFO MAIN TO C.O. 4.30/0.6 - Arlex.
SMH #52 To #53 - 363.0