

Name Laurie S. Caldwell

Service No. 31

Address 16 Dee Road

Location

Kind of Pipe

Size

Size of Main

~~Repair~~—Renewal—~~New Service~~ W.O. #4523

Location JAN 22 1968


Date	Material	Amount	Total	Date	Amount
5/67	Labor	108.72			
	10% O.H.	10.87	119 59	5-1-67	119 59
	43' 6" Transite pipe @ .88		37 84	6-8-73	58 95
	1/2 Bag Cement @ 1.55		78		158 95
	5 Ton Crushed stone @ 1.65		8 25		
	8 Ton gravel @ 1.10		8 80		
	6 Hrs. Trucking @ 3.00		18 00		
	2 Hrs. Loader @ 4.00		8 00		
	5 Hrs. Shovel @ 6.50		32 50		
			233 76		
	PRO-RATED 233.76 x 17yrs. =		158 95		
				5-1-67	Roots
				4-4-67	Roots
				1-1-66	Roots

DATE _____

TOWN OF LEXINGTON — BOARD OF PUBLIC WORKS

SEWER DIVISION

Sketch of Service Here

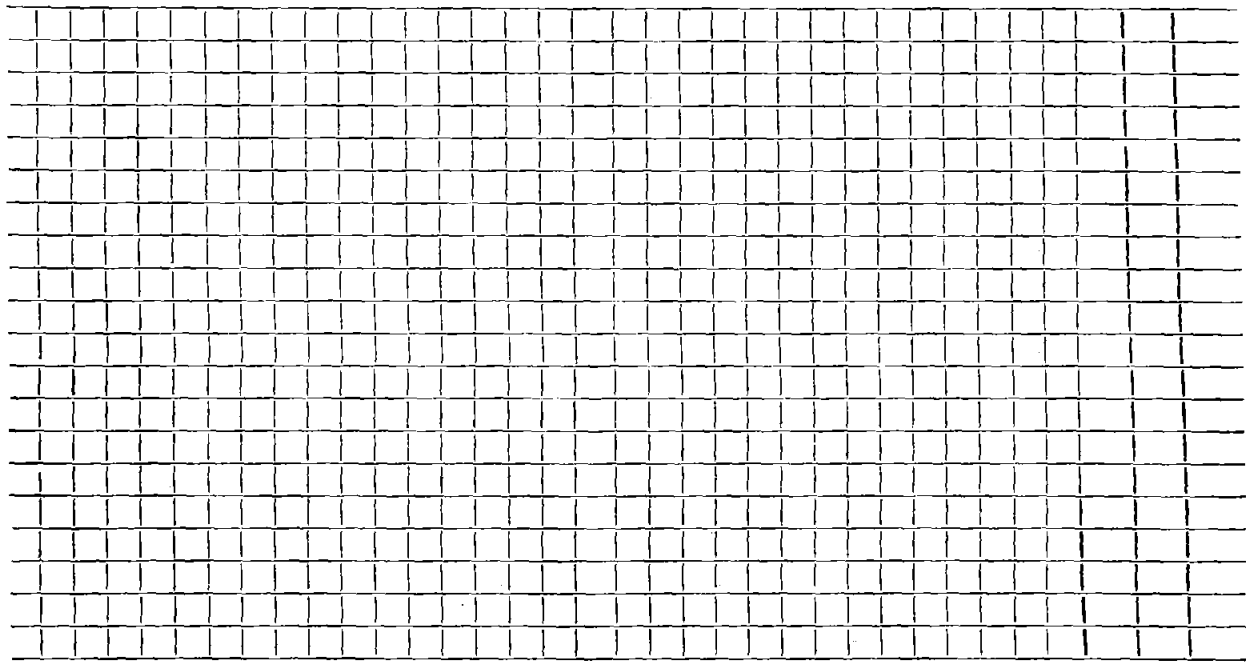

Connection made in Street. Work completed

Remarks: *Original Service 5-1-50*

.....
.....