

Name Lucy Shevenell

Service No. 1

Address 3 Dee Road

Location

Kind of Pipe

Size

Size of Main

~~Repair~~ Renewal ~~NEW SERVICE~~ W.O. #228

Location MAY 21 1979


Date	Material	Amount	Total	Date	Amount
4-3-79	Labor 100.72			2-5-79	250.00
5-4-79	" 46.64	147.36		6-1-79	33.98
	10% O.H.	14.74	162.10		283.98
30'	6" Transite pipe @1.50		45.00		
1	6" x 5" Nipple @1.75		8.75		
1	4" Donut		3.05		
1	6" Transite to Clay Adapter		4.83		
3	yds Loam @5.50		16.50		
10	lbs. Seed @1.00		10.00		
½	bag Fertilizer @4.00		2.00		
3	hrs. Trucking @3.00		9.00		
3½	hrs. Backhoe @6.50		22.75		
			283.98		
				7-28-79	Roots 15'-27' - AT Main
				5-22-72	Roots 3 Times
				11-3-69	solids

DATE _____

TOWN OF LEXINGTON — BOARD OF PUBLIC WORKS
SEWER DIVISION

Sketch of Service Here

3

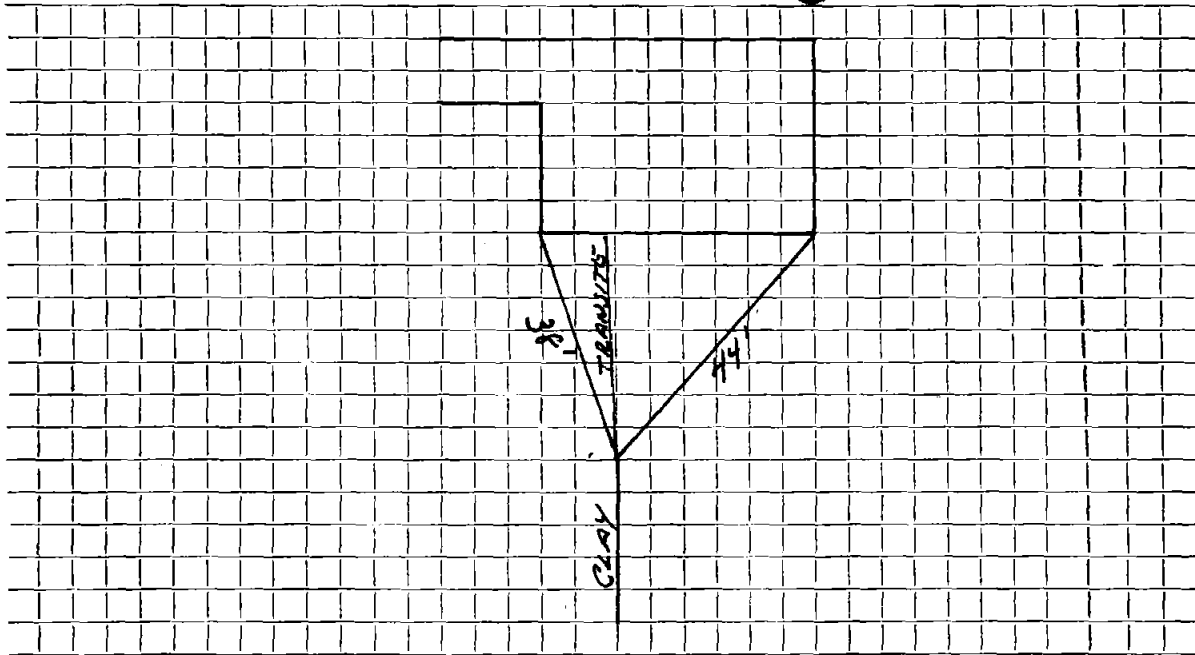

Connection made in Street. Work completed

Remarks: *Original Service 10-29-47*

.....
.....