

Name

Permit  
Service No. 4021

Address

8 Dee RD

Location

10T121-1671

Kind of Pipe

Size

Size of Main

Repair—Renewal—New Service

J. McLaughlin

Location


Date	Material	Amount	Total	Date	Amount
4/14/11	2' 6" 4" Cast				
	1 4" Fernco cast PVC				
	1 4" 22° bend				
	2' 4" PVC				
	1 4" Clean out				
	2' 4" PVC				
	1 4x6 Fernco				
	2' 6" PVC				
	1 6" 22° bend				
	60' 6" PVC				
	1 6" Fernco-PVC x A.C. 3.6" diam				
1953	1 6" Tee				
	1 6" Elbow				
	A.C. Pipe				

DATE \_\_\_\_\_

TOWN OF LEXINGTON — BOARD OF PUBLIC WORKS

SEWER DIVISION

Sketch of Service Here

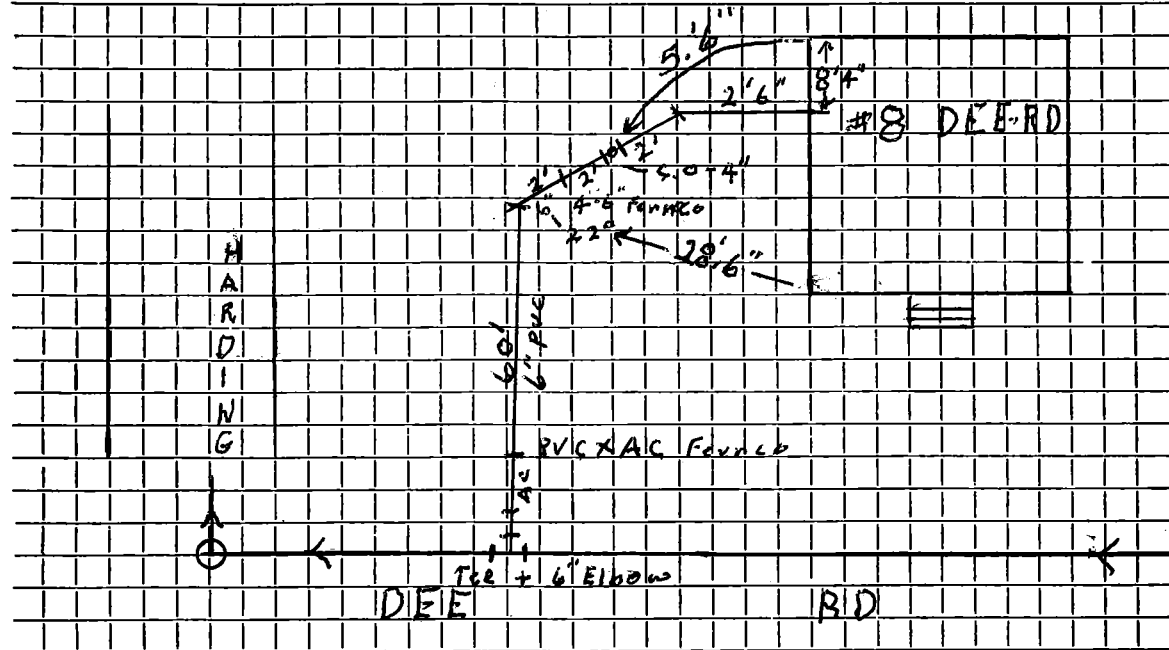

Connection made in Dee. RD ..... Street.      Work completed 4/14/11 J. McLaughlin

Remarks: .....  
.....  
.....