

Name

Service No.

Address

23 Deering Avenue

Location

Kind of Pipe

Size

Size of Main

~~Repair~~ ~~Renewal~~ New Service

Location

Date	Material	Amount	Total	Date	Amount
Sept. 17 '57	Labor	24 44			
	10% Overhead	2 44	26 88		
	20'-6" Transite pipe @.702		14 04	9-12-57	
	1 Bag Cement		1 32	58' 6" Transite	
	30 Stick Dynamite @.25		7 50	1 6" -22° Bend	
	7 Caps @.1775		1 24		
	1 hr. Town Shovel @ 6.50		6 50		
	1 hr. Trucking @.75		75		
	1 hr. Compressor @ 3.00		3 00		
	1/2 hr. Allis Chalmers @ 3.00		1 50		
	1 hr. Trucking @ 3.00		3 00		
	1 hr. Rodgers Trailer @ 3.00		3 00		
	<b>Labor</b>		<b>68.73</b>		
	Service to Curb- Bill when connected				

**TOWN OF LEXINGTON—DEPT. OF PUBLIC WORKS**  
**SEWER DIVISION**

DATE.....

NO. ....


The undersigned applies for the construction of a particular sewer connecting No.....  
Street and hereby agrees to comply with the Rules and Regulations governing the construction and use of Particular  
Sewers, as now or at any future time established by the Board of Selectmen.

Am't of estimate \$.....

Am't Paid \$.....

..... Owner

**Sketch of Service Here**

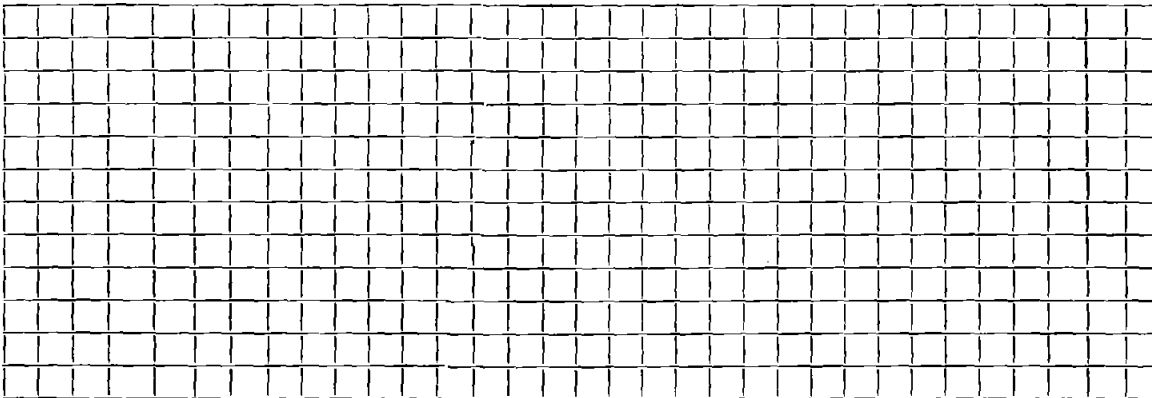

Connection made in..... Street.

Work completed.....19..

Remarks: