

Name *Oakmount Realty Trust*

Service No.

Address *24 Deering Avenue*

Location

Kind of Pipe

Size

Size of Main

Repair—Renewal—New Service

Location


Date	Material	Amount	Total	Date		Amount
9/11/57	Labor	7 . 53				
	10% O.H.	75	8.28			
63'	6" Transite @.70		44.10			
1	hr. Trucking @.75		75			
			\$53.13	9/2/87	21'1" 6" P.V.C.	
					1 19"-8" PVC Nipple	
					1 8" x 8" x 6" Wye	
					1 15"-8" PVC Nipple	
					1 6" PVC to transite fernco adapt.	
					1 8" PVC to clay fernco adpt.	

DATE \_\_\_\_\_

TOWN OF LEXINGTON — BOARD OF PUBLIC WORKS

SEWER DIVISION

Sketch of Service Here **24**

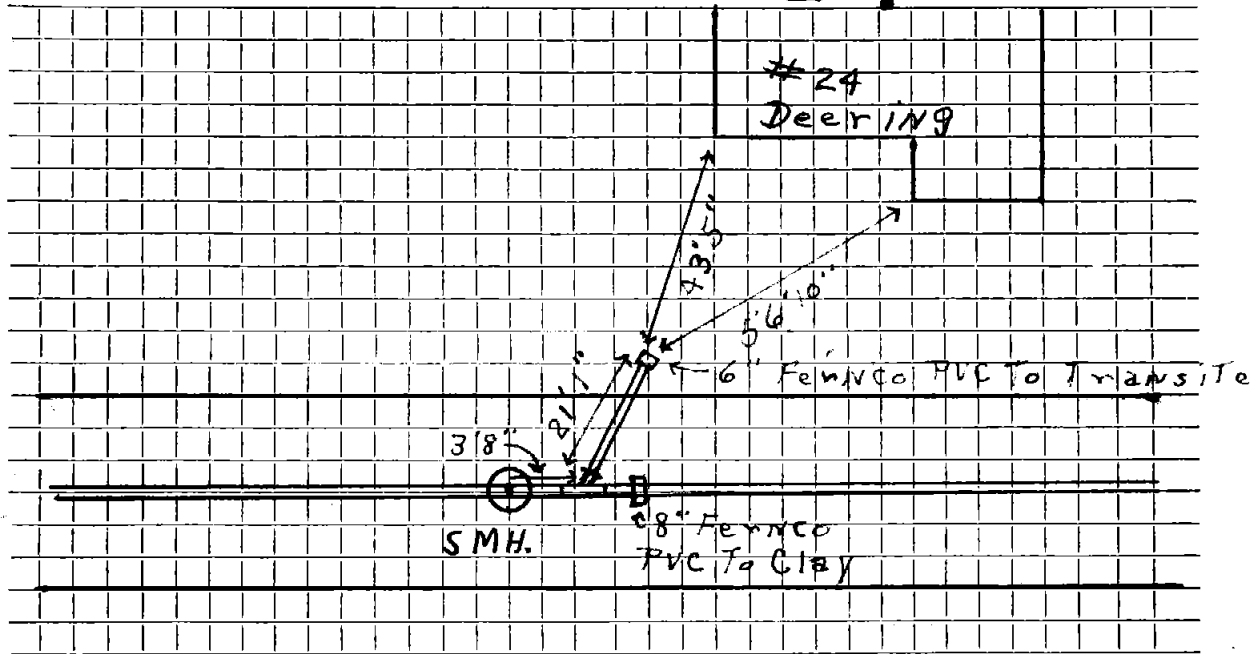

Connection made in ..... Street. Work completed .....

Remarks: .....  
.....  
.....