

Name **Herbert McConchie**

Service No. **129**

Address **26 Deering Avenue**

Location

Kind of Pipe

Size

Size of Main

~~Repair~~ ~~Renewal~~ **New Service**


Location *Camden 11-9-59*

Date	Material	Amount	Total	Date	Amount
8-14-59	Labor	16.12		8-12-59	150.00
8-24-59	"	23.37	39.49	11-9-59	41.13
	10 % O. H.	3.95	43.44		108.07
49'	6" Transite pipe @.70		34.30		
1	6" 11 1/4" Transite Bend		5.10		
2	6" 11 1/4" Transite Elbow @2.24		4.48		
16 1/4	ton Concrete Sand @ 1.00 per ton		6.25		
2	hrs. Town Shovel @6.50		13.00		
2	hrs. Trucking @.75		1.50		
			<u>108.07</u>		

DATE _____

TOWN OF LEXINGTON — BOARD OF PUBLIC WORKS
SEWER DIVISION

Sketch of Service Here

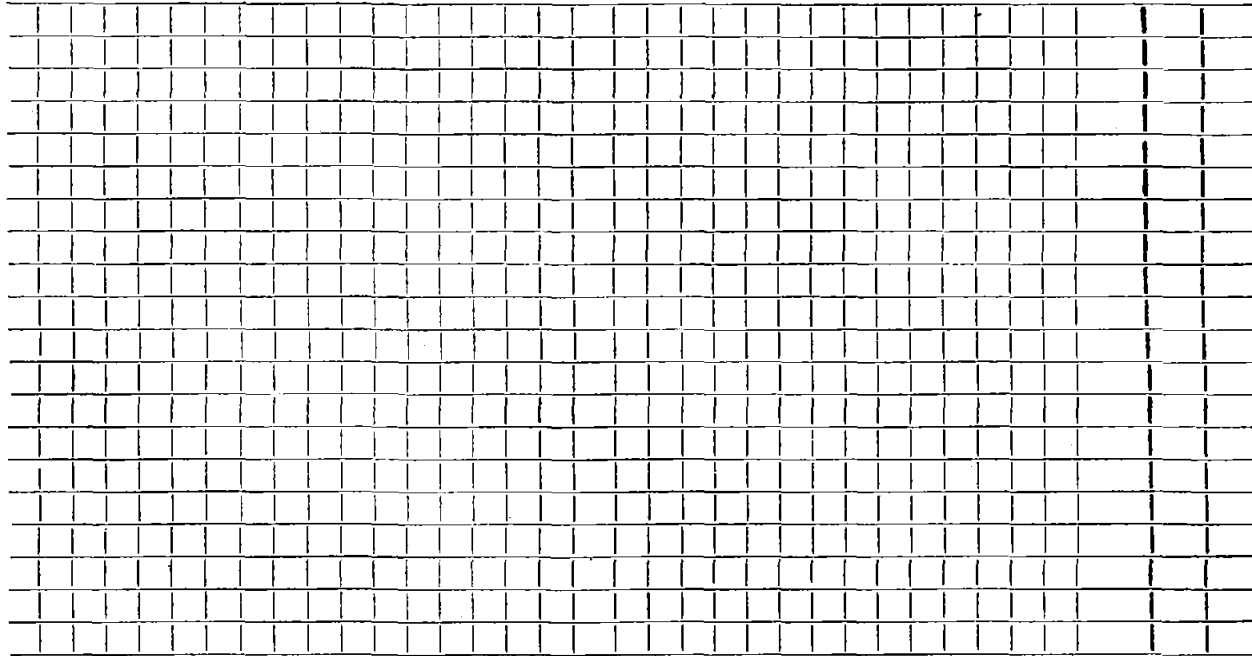

Connection made in Street. Work completed

Remarks:
.....
.....