

Name Gilbert Harris

Service No. 184

Address 18 Deering Ave., Lexington, Mass.

Location

Comm. 12/31/57

Kind of Pipe

Size

Size of Main

~~Repair or Renewal~~ - New Service

PERMIT NO. 0998 - MCLAUGHLIN

Location

Date	Material	Amount	Total	Date	Amount
11/7/57	Labor	14 18		10-10-57	Deposit \$ 150.00
11/8/57	Labor	25 99		12-31-57	Refund 44 21
	10% Overhead	40 17 4 02	44 19		\$ 105 79
	58'-6" Transite Pipe @.70		40 60		Non Charge
	3 hrs. Town Shovel @ 6.50		19.50		
	2 hrs. Trucking @.75		1 50		
			44 19		
			105 79		
9/2/1997	1-SADDLE				
	1-6" 45° BEND				
	2-WYE CLEANOUTS				
	labor 4 "X6" FERRO				
	59.5' -6" Ø PVC				

TOWN OF LEXINGTON—DEPT. OF PUBLIC WORKS

SEWER DIVISION

DATE.....

NO.....


The undersigned applies for the construction of a particular sewer connecting No.....
 Street and hereby agrees to comply with the Rules and Regulations governing the construction and use of Particular
 Sewers, as now or at any future time established by the Board of Selectmen.

Am't of estimate \$.....

Am't Paid \$.....

..... Owner

Sketch of Service Here

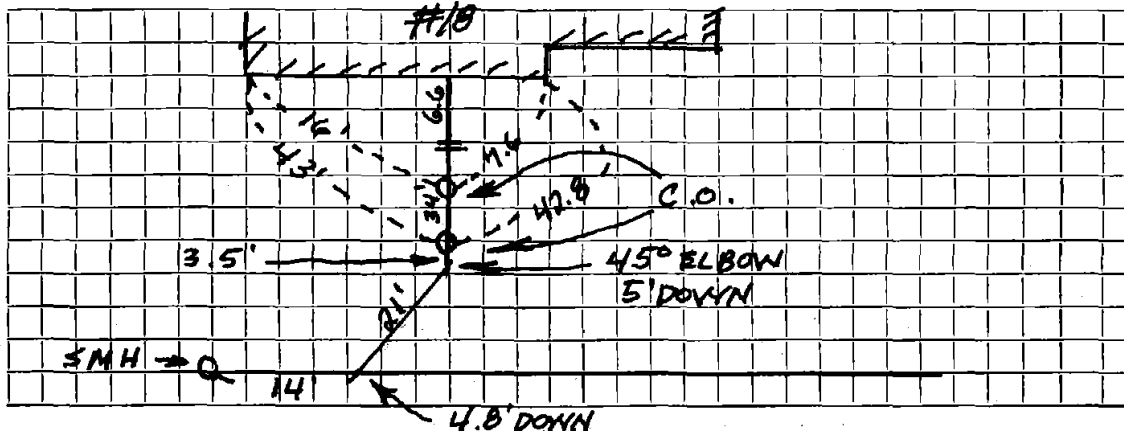

Connection made in..... Street.

Work completed.....19..

Remarks:

BOOK 97-3