


DATE _____

TOWN OF LEXINGTON — BOARD OF PUBLIC WORKS

SEWER DIVISION

SEWER
Sketch of Service Here **13**

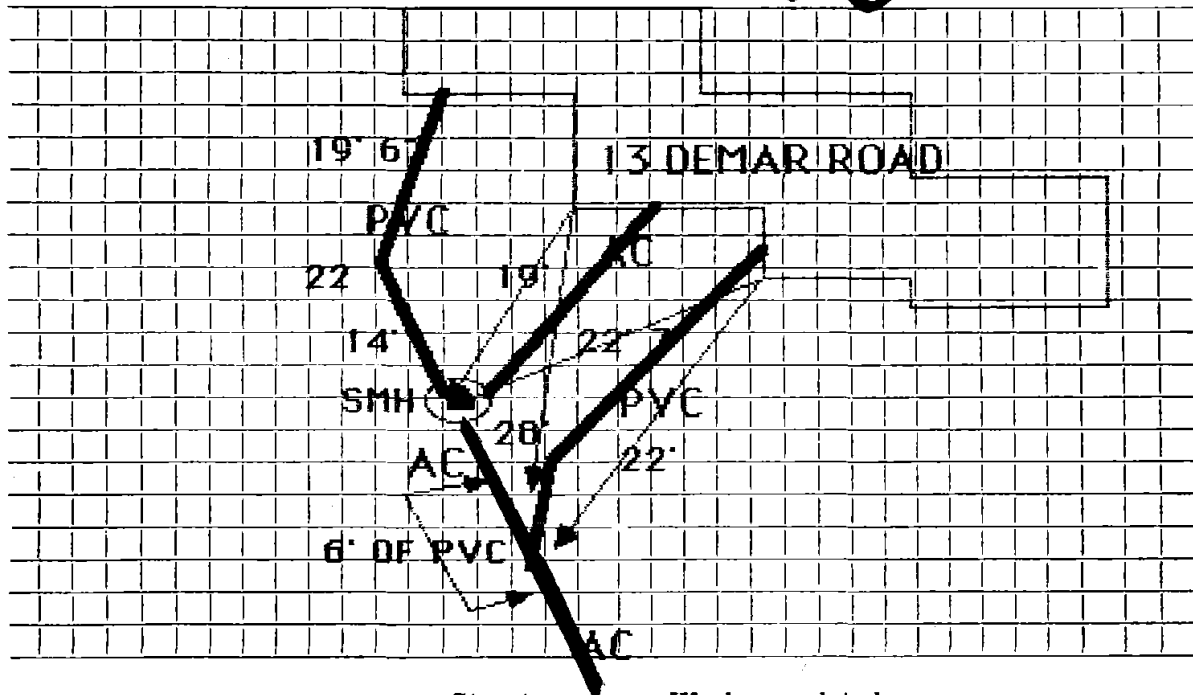

Connection made in Street. Work completed

Remarks:

.....