


DATE _____

TOWN OF LEXINGTON — BOARD OF PUBLIC WORKS
SEWER DIVISION

Sketch of Service Here

17

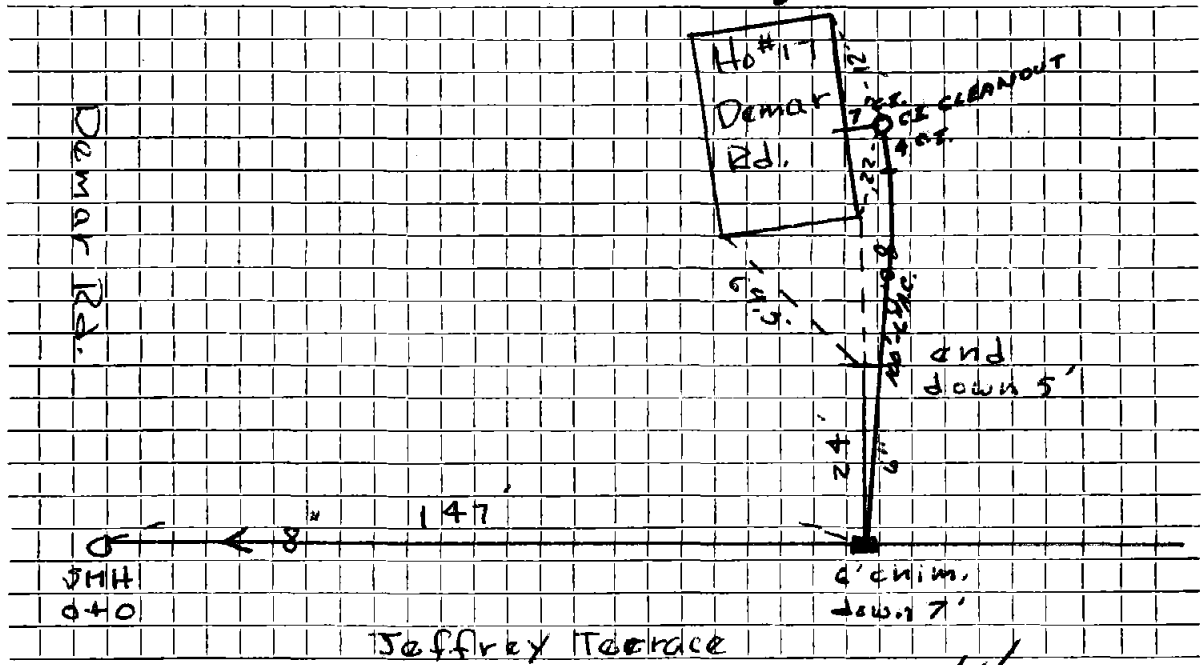

Connection made in Jeffrey Terrace Street.

Work completed 9/4/75

Remarks:

.....

.....