


DATE _____

TOWN OF LEXINGTON — BOARD OF PUBLIC WORKS
SEWER DIVISION

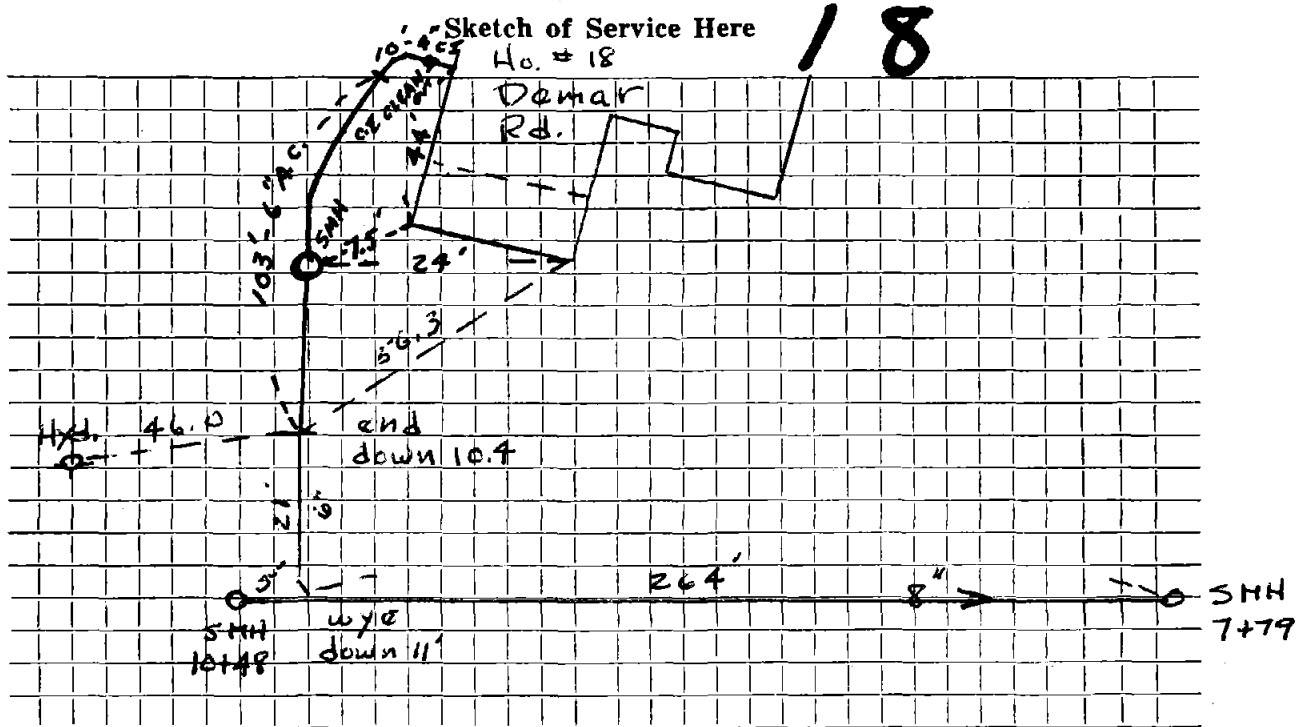

Connection made in Demar Rd. Street. Work completed 7/3/25

Remarks: _____

