




DATE \_\_\_\_\_

TOWN OF LEXINGTON — BOARD OF PUBLIC WORKS  
SEWER DIVISION

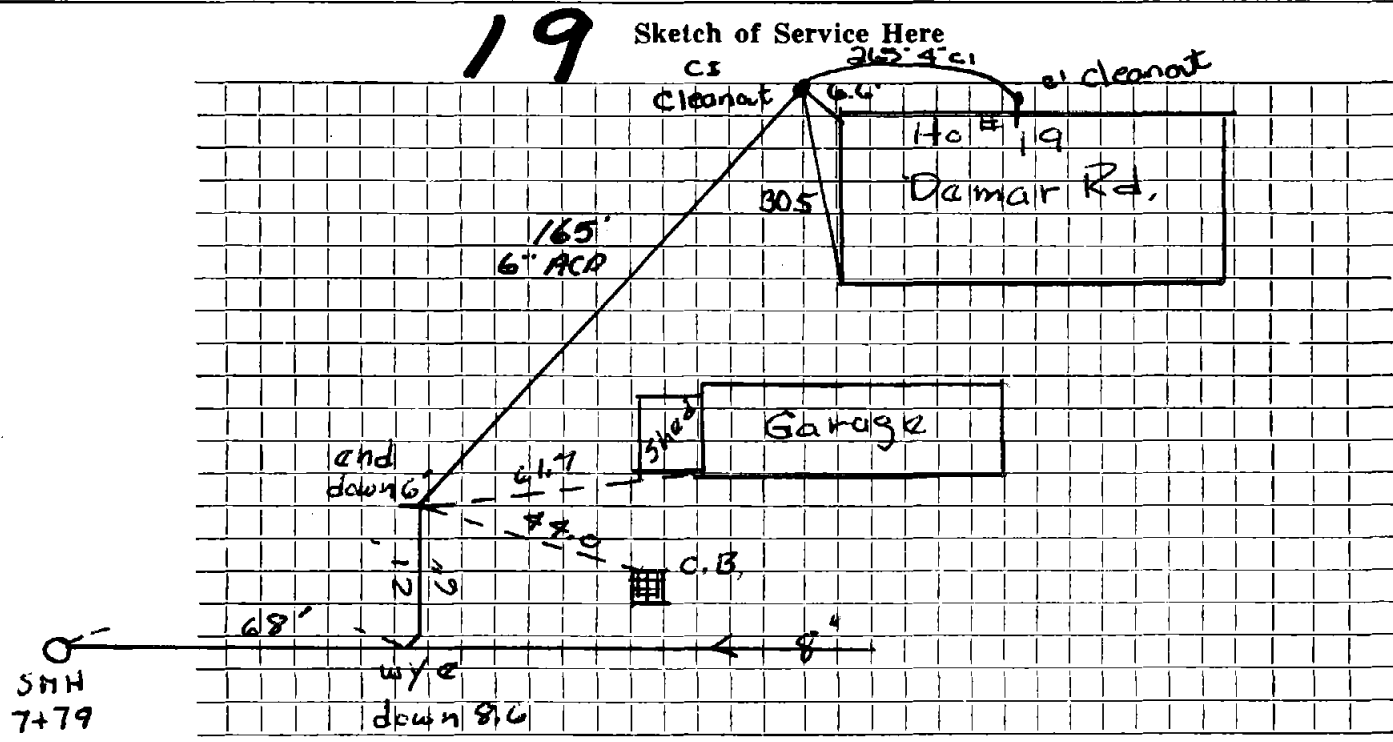

Connection made in Demar Rd. Street. Work completed .....

Remarks: .....

.....

.....