


DATE _____

TOWN OF LEXINGTON — BOARD OF PUBLIC WORKS

SEWER DIVISION

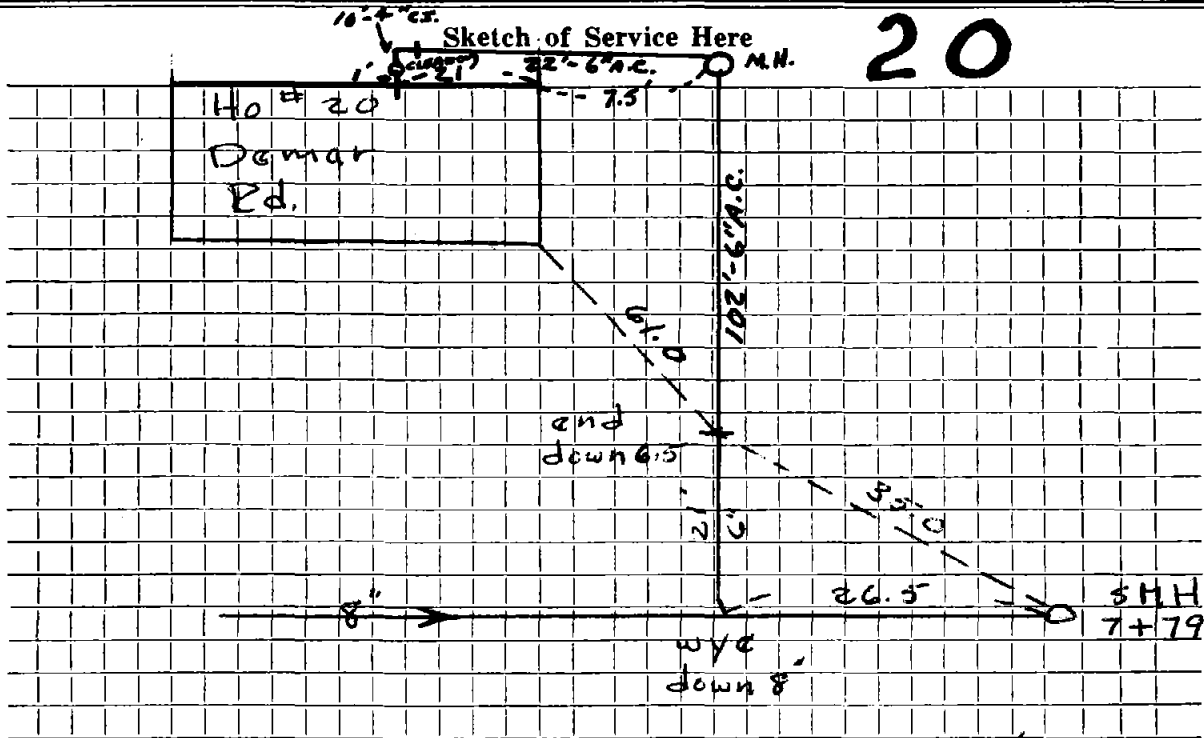

Connection made in Demar Rd. Street. Work completed 7/1/75

Remarks:

.....

.....