

Name Alfred Bloom

Service No.

64

Address 21 Damar Rd.

Location

Kind of Pipe A.C.

Size 6"

Size of Main 8"


Repair—Renewal—New Service Valeri Const. #2725

Location AUG 16 1976

Date	Material	Amount	Total	Date	Amount
<del>11-15-74</del>	<del>23' - 6" A.C. @</del>	<del>#10.00 =</del>	<del>#230.00</del>	6-30-5	Deposit 290.00
7/1/75	168" 6" Transite Pipe				
	7' 4" Cast Iron Pipe				
				11-15-74	
				23' 6" A.C.	

DATE \_\_\_\_\_

TOWN OF LEXINGTON — BOARD OF PUBLIC WORKS  
SEWER DIVISION

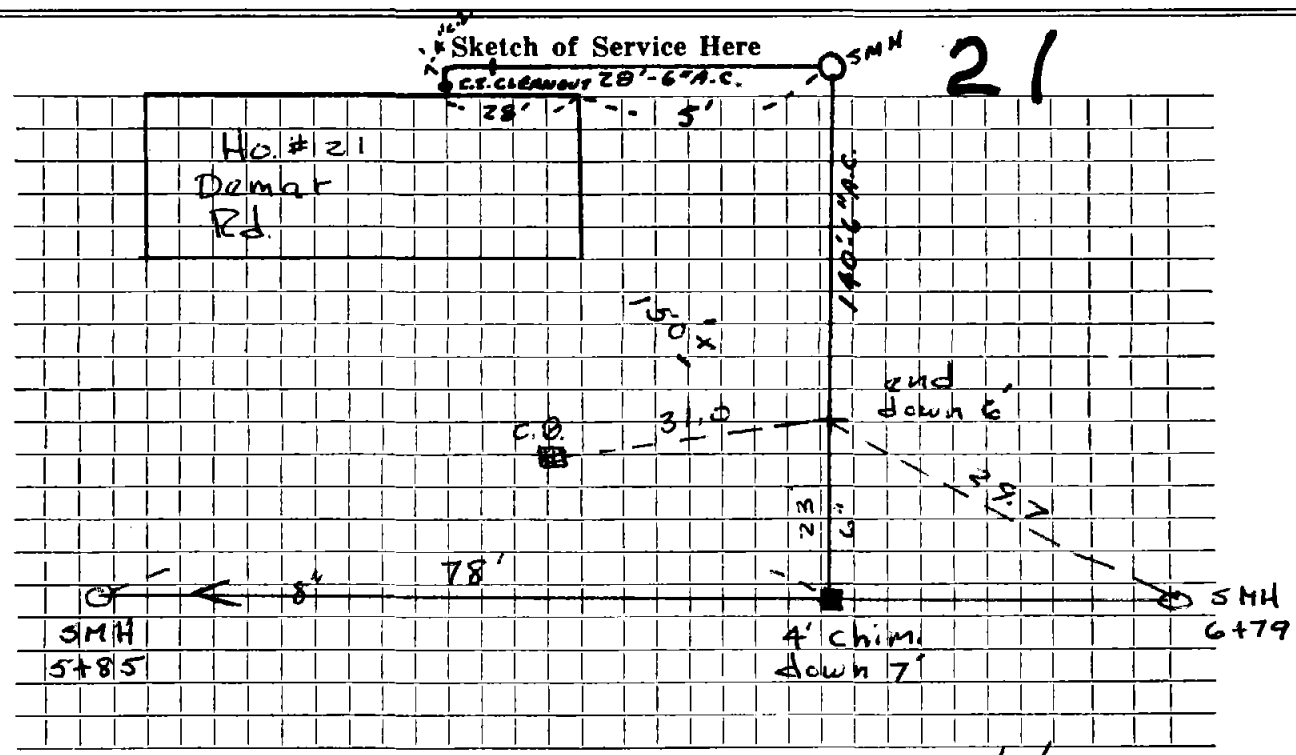

Connection made in Demar Rd. Street. Work completed 4/8/76

Remarks: .....

.....

.....