

DATE _____


TOWN OF LEXINGTON — BOARD OF PUBLIC WORKS

SEWER DIVISION

C.I. clean out

Sketch of Service Here
No. # 23

23

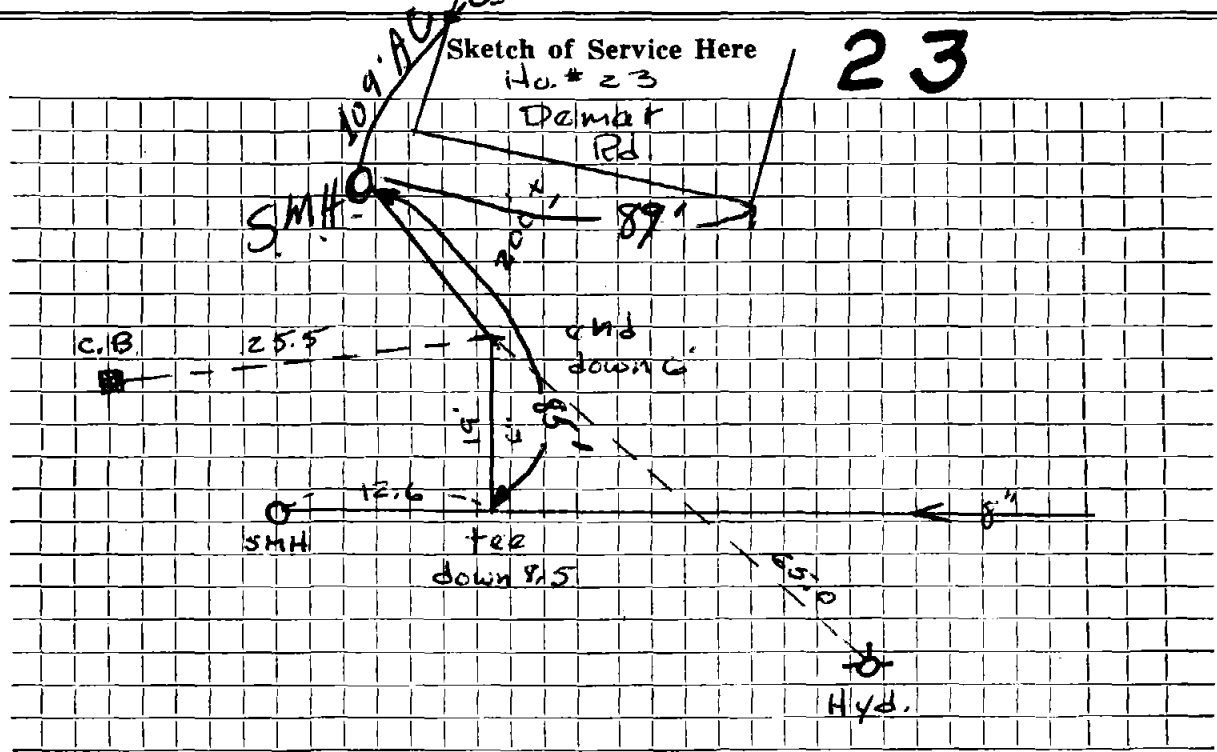

Connection made in Demar Rd. Street. Work completed

Remarks:
.....
.....