

DATE _____

TOWN OF LEXINGTON — BOARD OF PUBLIC WORKS


SEWER DIVISION

24

Sketch of Service Here

Ho. # 24

Damar Rd.

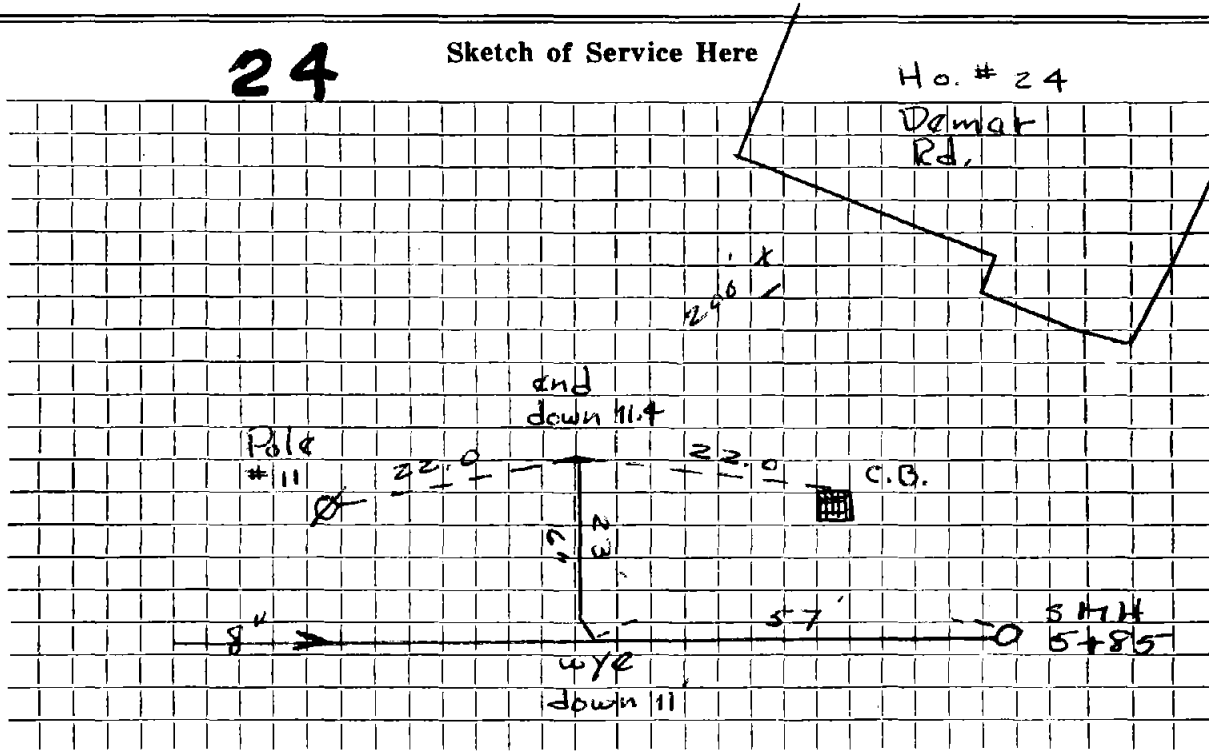

Connection made in Damar Rd. Street. Work completed

Remarks:
.....
.....

7/10/95

Inspection

H. G. Higgins
3110112

✓ HSE# 24 DENIED IT

