

Name

Service No.

Address 25 Demar Rd.

Location

Kind of Pipe A.C.

Size 6"

Size of Main 8"

Repair—Renewal—New Service DAVE SANTO 1998

Location

Date	Material	Amount	Total	Date	Amount
<del>11-16-74</del>	<del>24' - 6" A.C. ♂</del>	<del>\$10.00 =</del>	<del>\$240.00</del>		
7/8/98	184' 6" PVC			11-16-74	
	1 6" WYE			24' 6" A.C.	
	1 6"x4" WYE CLEANOUT				
	1 4"x6" FERNCO				
	1 4" 45° BEND				
	1 4" FERNCO				
11.4	4" PVC				

DATE \_\_\_\_\_

TOWN OF LEXINGTON — BOARD OF PUBLIC WORKS


SEWER DIVISION

25

Sketch of Service Here

Ho. # 25  
Demar  
Rd.

Pole # 14

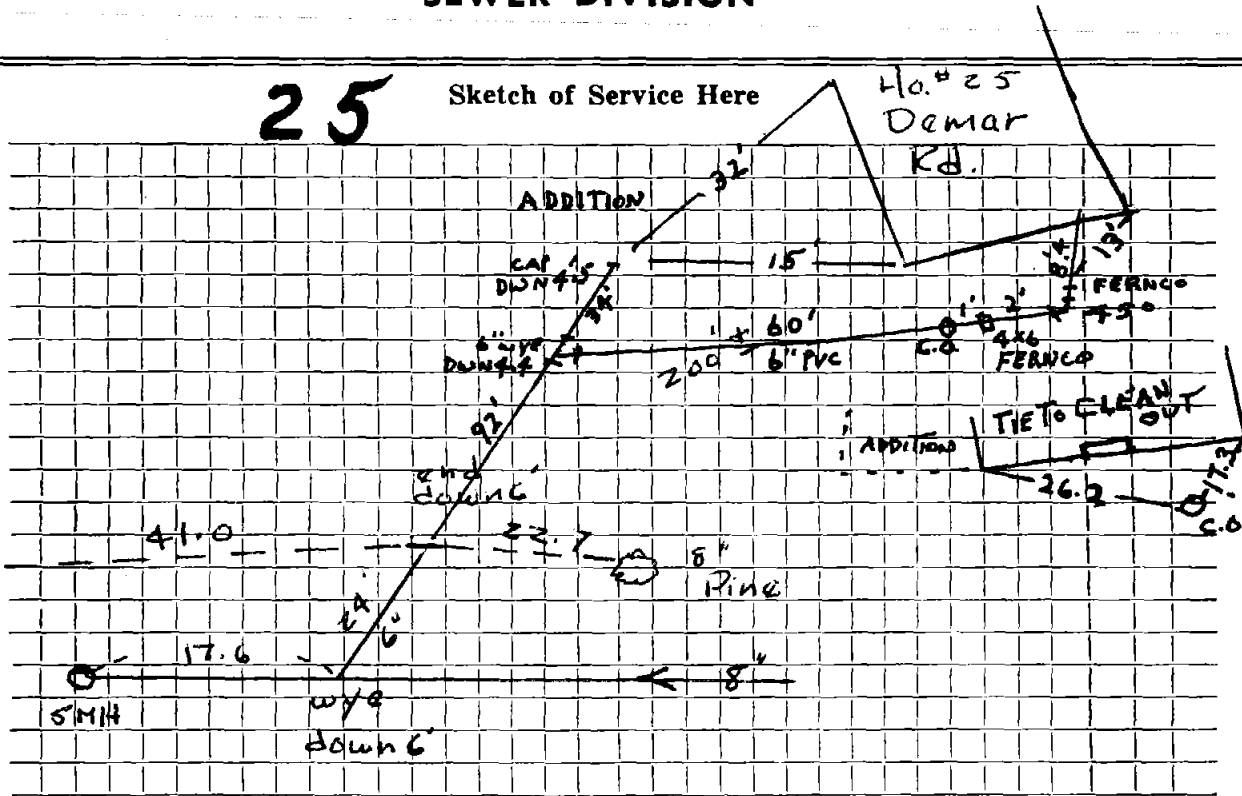

Connection made in Demar Rd. Street. Work completed .....

Remarks: .....