

Name

Service No.

Address 26 Demar Rd.

Location

Kind of Pipe A.C.

Size 6"

Size of Main 8"

Repair—Renewal—New Service

Location

Date

Material

Amount

Total

Date

Amount

~~11-16-74~~ 21' 6" A.C. Ⓟ \$10.00 = \$210.00

11-16-74
21' 6" A.C.


DATE _____

TOWN OF LEXINGTON — BOARD OF PUBLIC WORKS

SEWER DIVISION

Sketch of Service Here

26

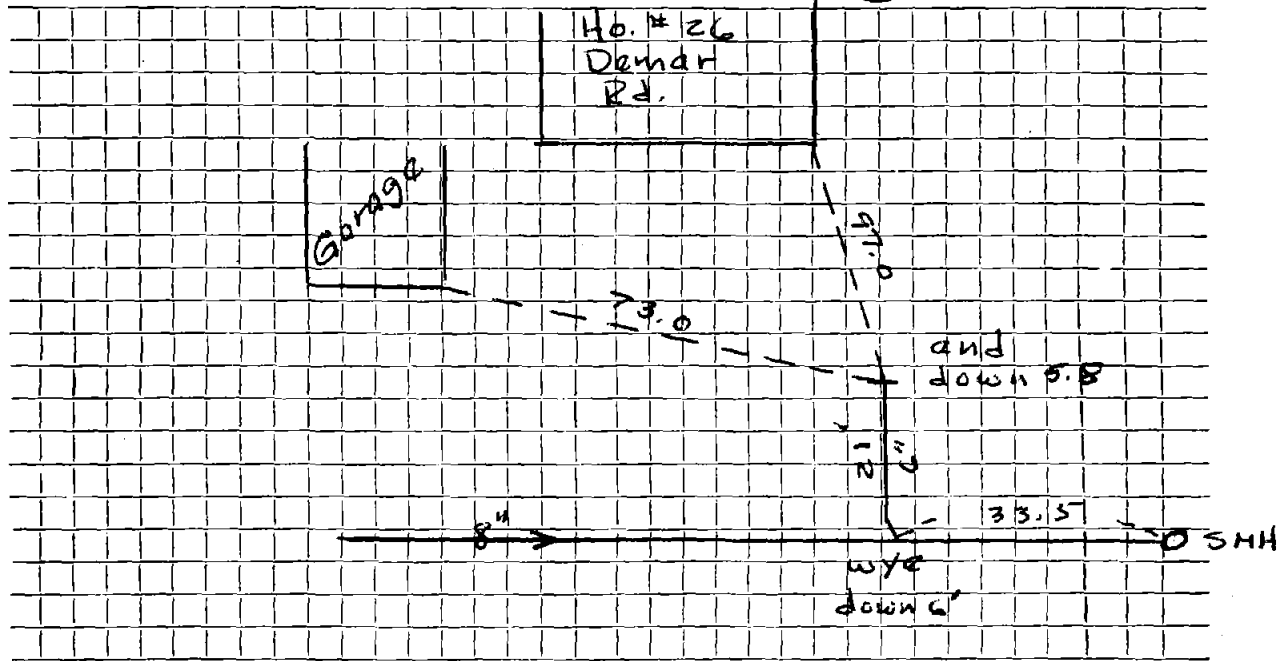

Connection made in Demar Rd. Street. Work completed

Remarks:

.....

.....