

Name Susana L. Gorstein

Service No. 5A

Address 27 Demar Rd.

Location

Kind of Pipe A.C.

Size 6"

Size of Main 8"

Repair—Renewal—New Service Valeri Const. #2941


Location AUG 16 1976

Date	Material	Amount	Total	Date	Amount
11-16-74	24' 6" AC @	10.00	240.00	3/18/76	Deposit
4/8/76	6" Transite Pipe	149.6			240.00
	4" Cast Iron Pipe	10'			
				11-16-74	
				24' 6" A.C.	
				12-1-97	Blockage is between mH's in yard 25' up from mH in front of house Homeowners problem

DATE _____

TOWN OF LEXINGTON — BOARD OF PUBLIC WORKS

SEWER DIVISION

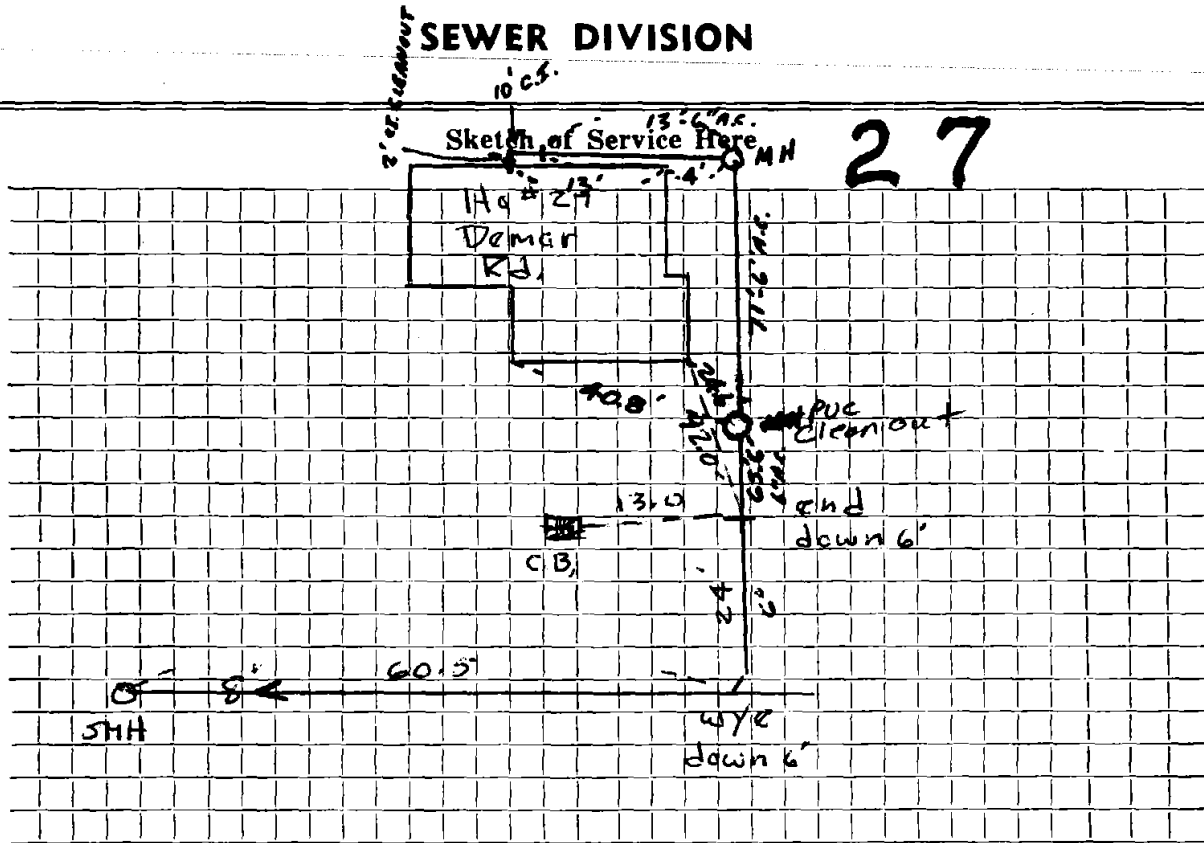

Connection made in Damar Rd. Street. Work completed 7/31/75

Remarks: Repair Made 1-25-99, 5' From manhole in backyard. 63' of 6" PUC to New Cleanout @ same location and same T.I.C.