

Name Pedro Lillienfield

Service No. 73 (75)

Address 28 Demar Rd.

Location

Kind of Pipe A.C.

Size 6"

Size of Main 8"

Repair—Renewal—New Service Valeri Const. #2698

Location AUG 16 1976


Date		Material	Amount	Total	Date	Amount
<del>1-16-74</del>	<del>74</del>	<del>21' - 6" A.C. @</del>	<del>\$10.00 =</del>	<del>210.00</del>	7-30-5	Deposit 210 00
7/31/75	52'	6" Transite Pipe				
	16'	4" Cast Iron Pipe				
					11-16-74	
					21' 6" A.C.	
					3/30/92	Respond + measure RA

DATE \_\_\_\_\_

TOWN OF LEXINGTON — BOARD OF PUBLIC WORKS  
SEWER DIVISION

Sketch of Service Here

28

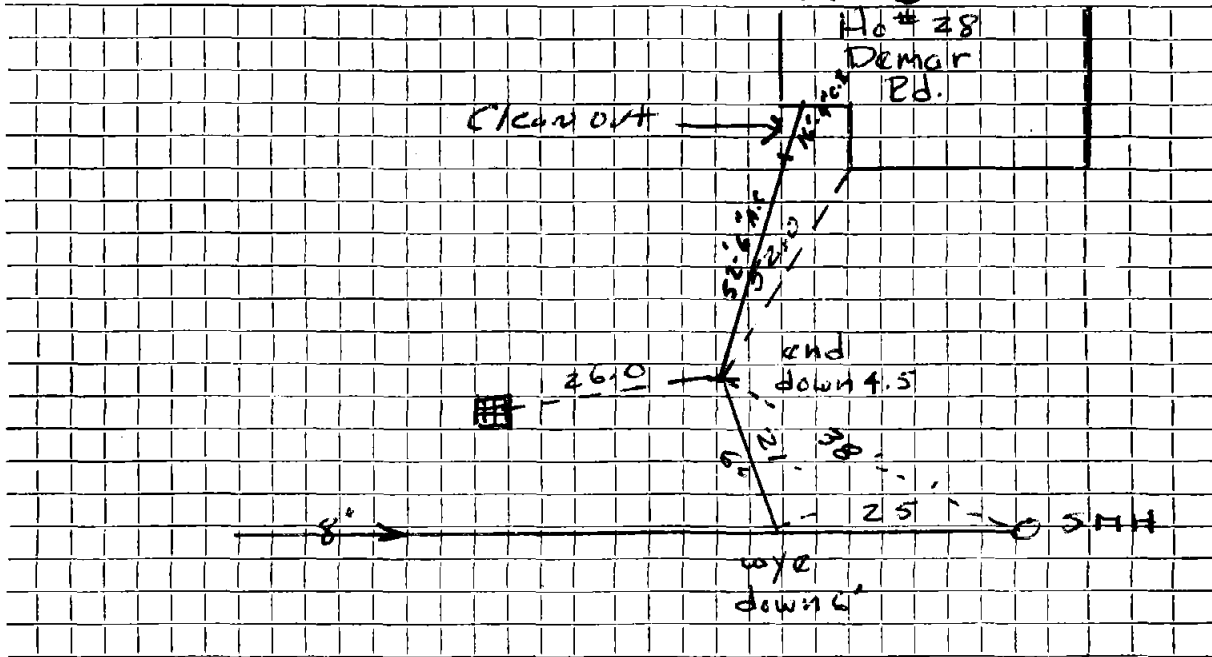

Connection made in Demar Rd. Street. Work completed 6/5/74

Remarks: \_\_\_\_\_  
\_\_\_\_\_  
\_\_\_\_\_