

Name Robert Bond

Service No. 51

Address

6 Demar Rd

Lot 5

Location

Kind of Pipe

Size

Size of Main

Repair—Renewal—New Service

Aldo #676

Location JUL 24 1967

Date		Material	Amount	Total	Date		Amount
1967	23	1" Transite Pipe @ 7.00		161.00	5-22-67	Deposit	161.00
5-24-67	111.5	6" Transite pipe					
					1967	23' 6" Transite	
					4/23/63	Solids	


DATE _____

TOWN OF LEXINGTON — BOARD OF PUBLIC WORKS

SEWER DIVISION

Sketch of Service Here

6

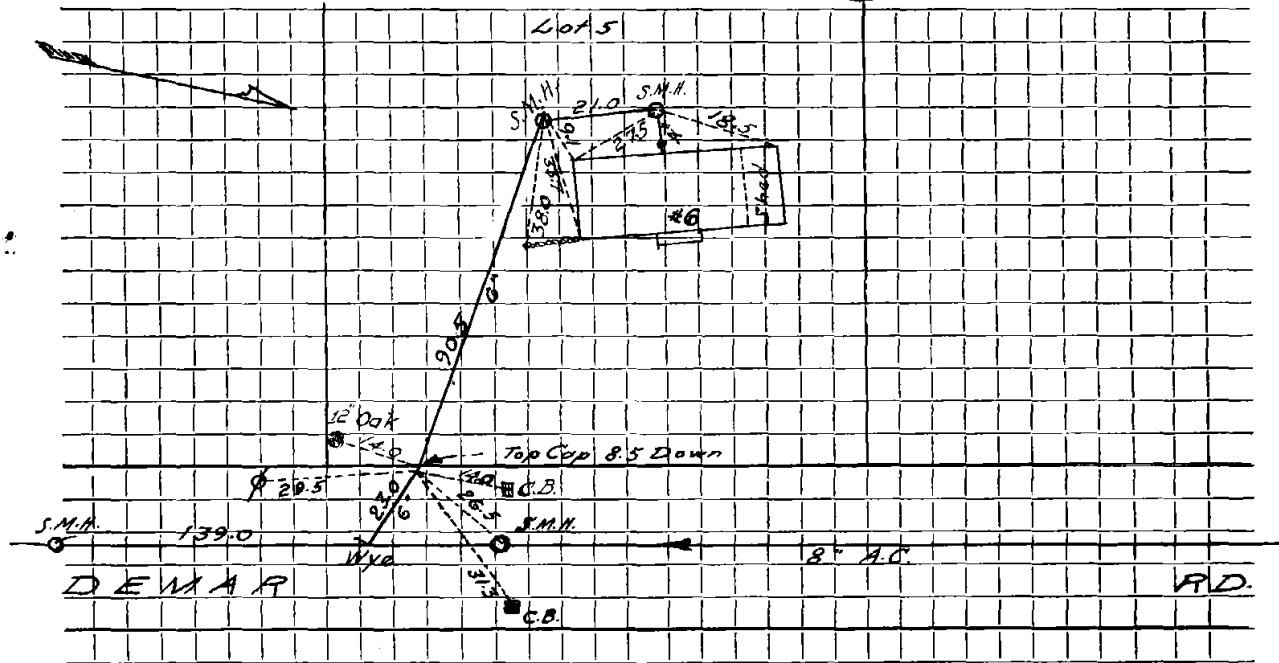

Connection made in Street. Work completed

Remarks:
.....
.....