


DATE NOV. 18, 1996

TOWN OF LEXINGTON — BOARD OF PUBLIC WORKS
SEWER DIVISION

8

Sketch of Service Here

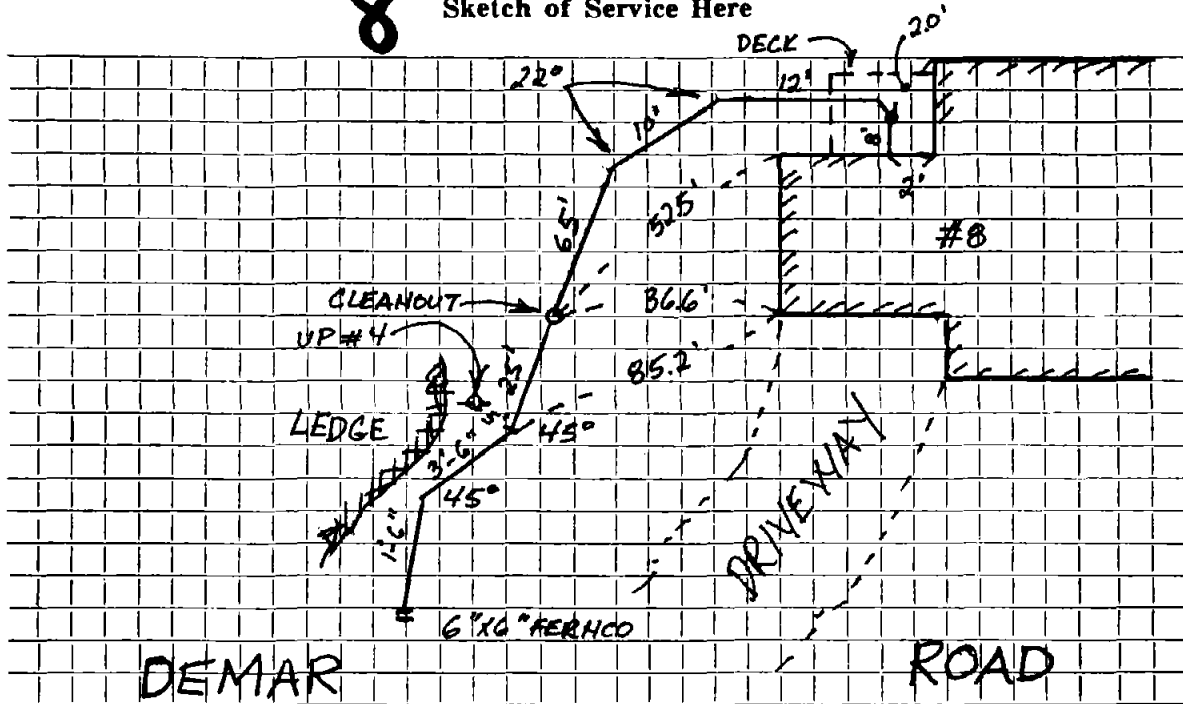

DEMAR

ROAD

Connection made in DEMAR ROAD Street.

Work completed ARLEX OIL CORP.

Remarks:

.....

BOOK 96-5

J.W.