


DATE AUG 22 1997

TOWN OF LEXINGTON — BOARD OF PUBLIC WORKS

SEWER DIVISION

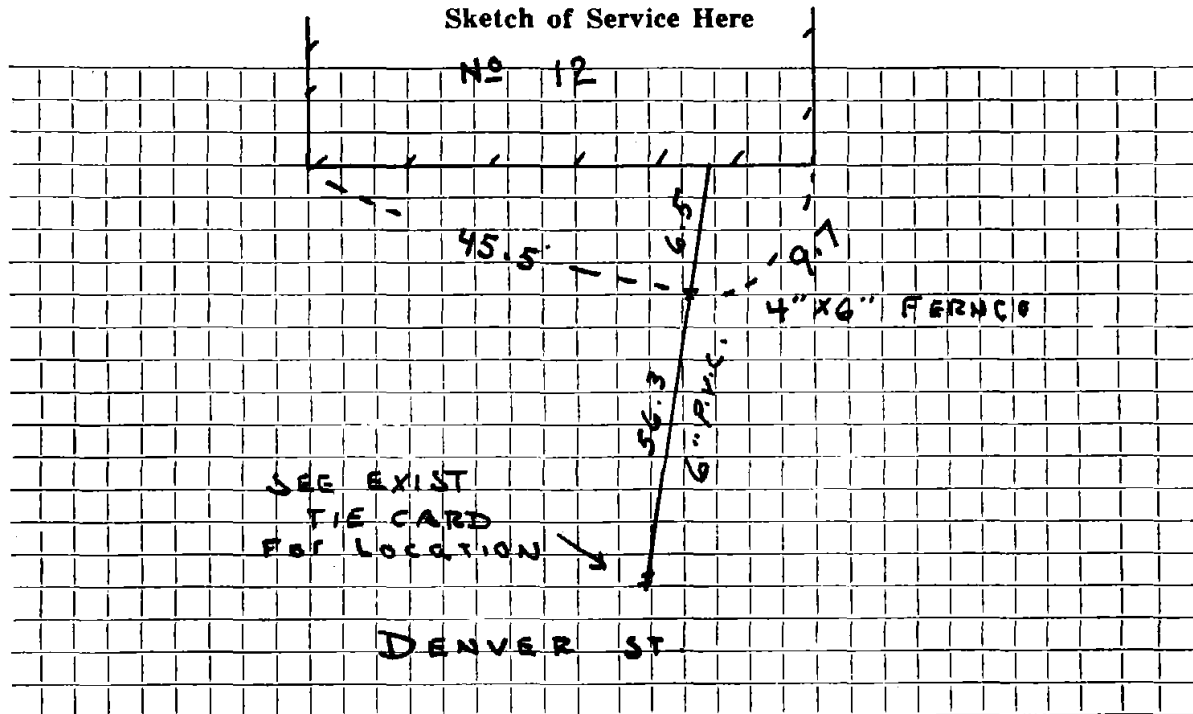

Connection made in DENVER..... Street.

Work completed A. CARDILLO & SONS.....

Remarks:

..... FIELD BOOK 97-3 TJM