


DATE _____

TOWN OF LEXINGTON — BOARD OF PUBLIC WORKS

SEWER DIVISION

Sketch of Service Here

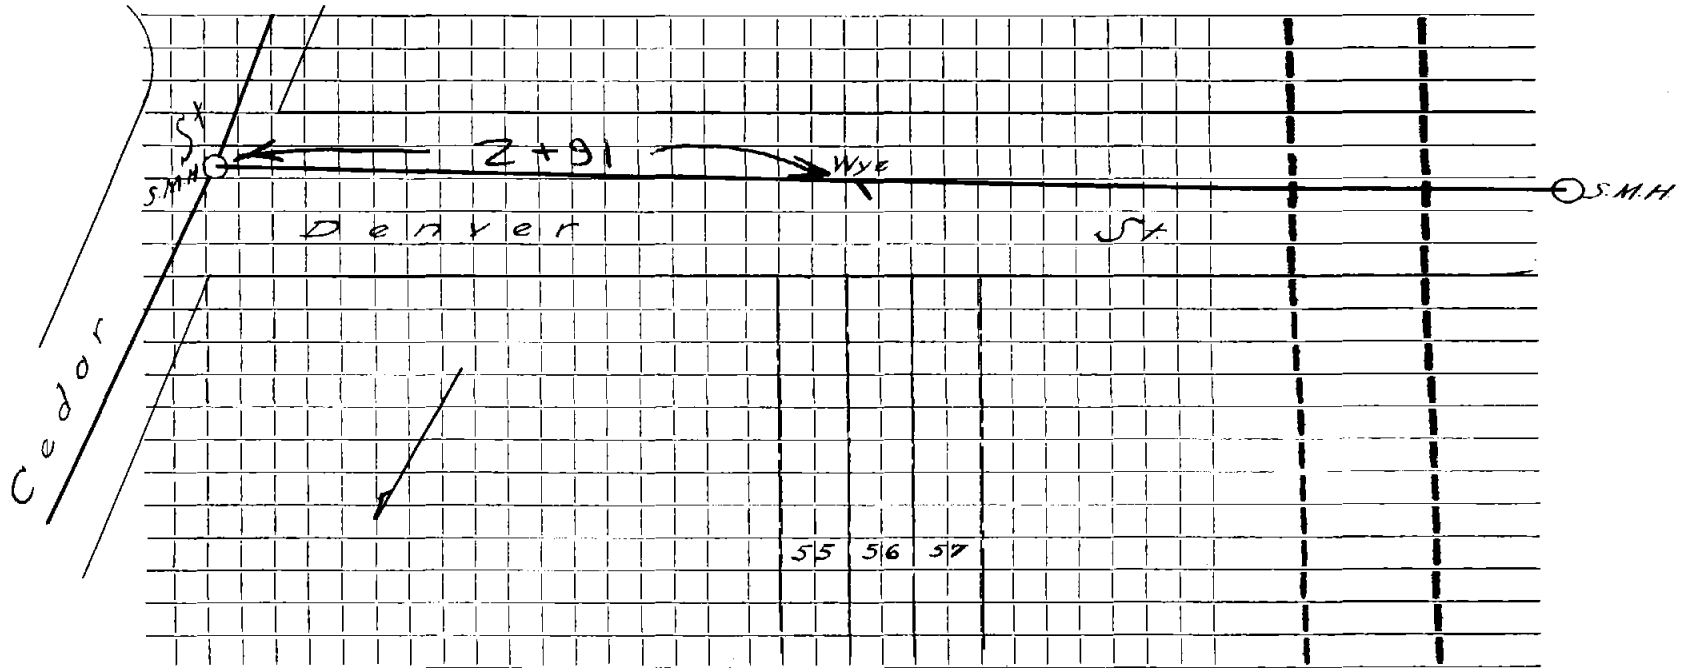


Connection made in Street. Work completed

Remarks:
.....
.....

DATE _____

TOWN OF LEXINGTON — BOARD OF PUBLIC WORKS
SEWER DIVISION

Sketch of Service Here

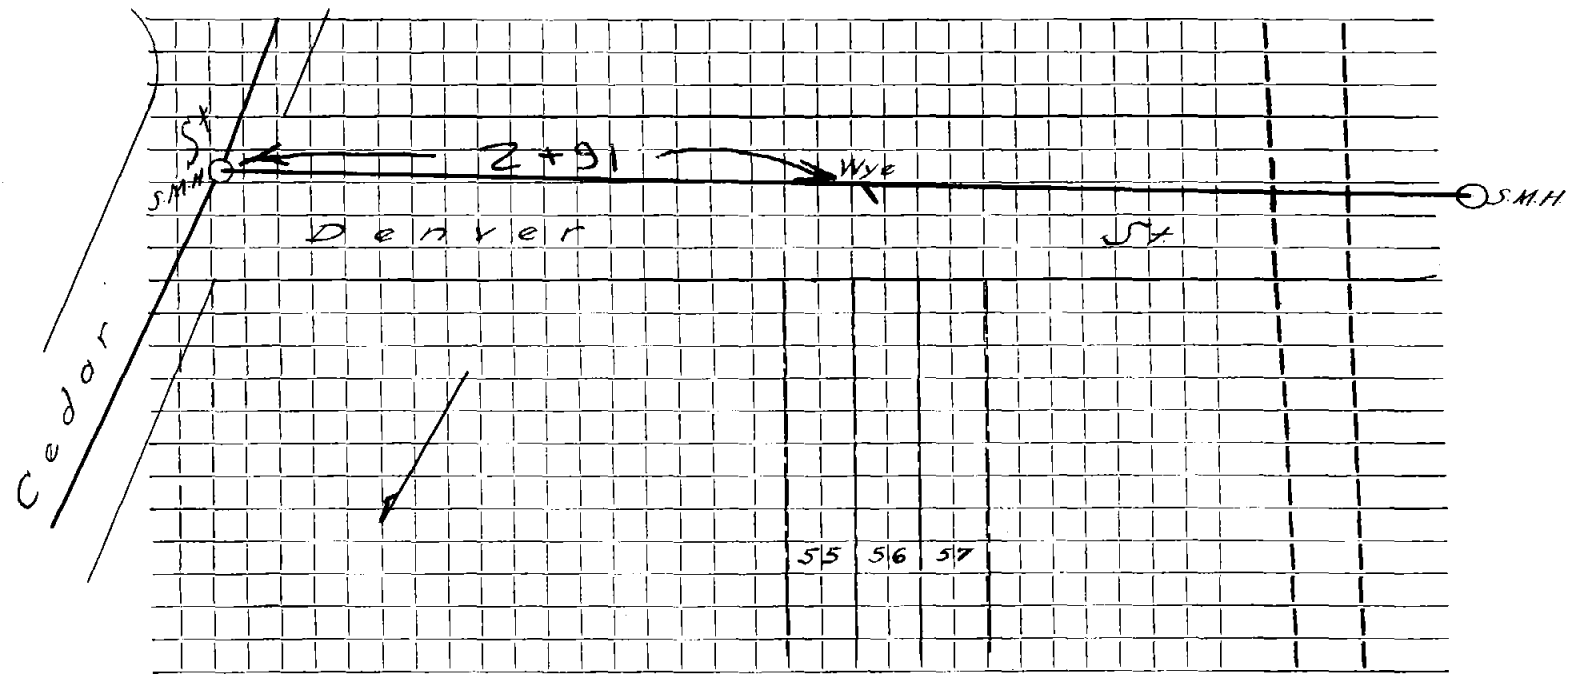

Connection made in Street. Work completed

Remarks:
.....
.....

STREET TO LEXINGTON DEPOT

LEXINGTON
DEPOT

Boston
and
Maine
R.R.

Henry of
Lewis Hunt

Bates House

MASSACHUSETTS

AVE

M.H. 027.51
271.5

227.87
60.0
133.0

M.H. 151.3

106.8
107.8

61.1

M.H. 0.0

129.8

129.8

1777

40

45

45

40

45

45

