

Name

Service No.

Address 3 Denver Street

Location

Kind of Pipe

Size

Size of Main

Repair—Renewal— New Service

Location

Date	Material	Amount	Total	Date	Amount
<del>1965</del>	<del>23 1/2" 6" Transite pipe @6.00</del>		141.00		
				1965	
				23.6	6" Transite




DATE \_\_\_\_\_

TOWN OF LEXINGTON — BOARD OF PUBLIC WORKS

SEWER DIVISION

Sketch of Service Here

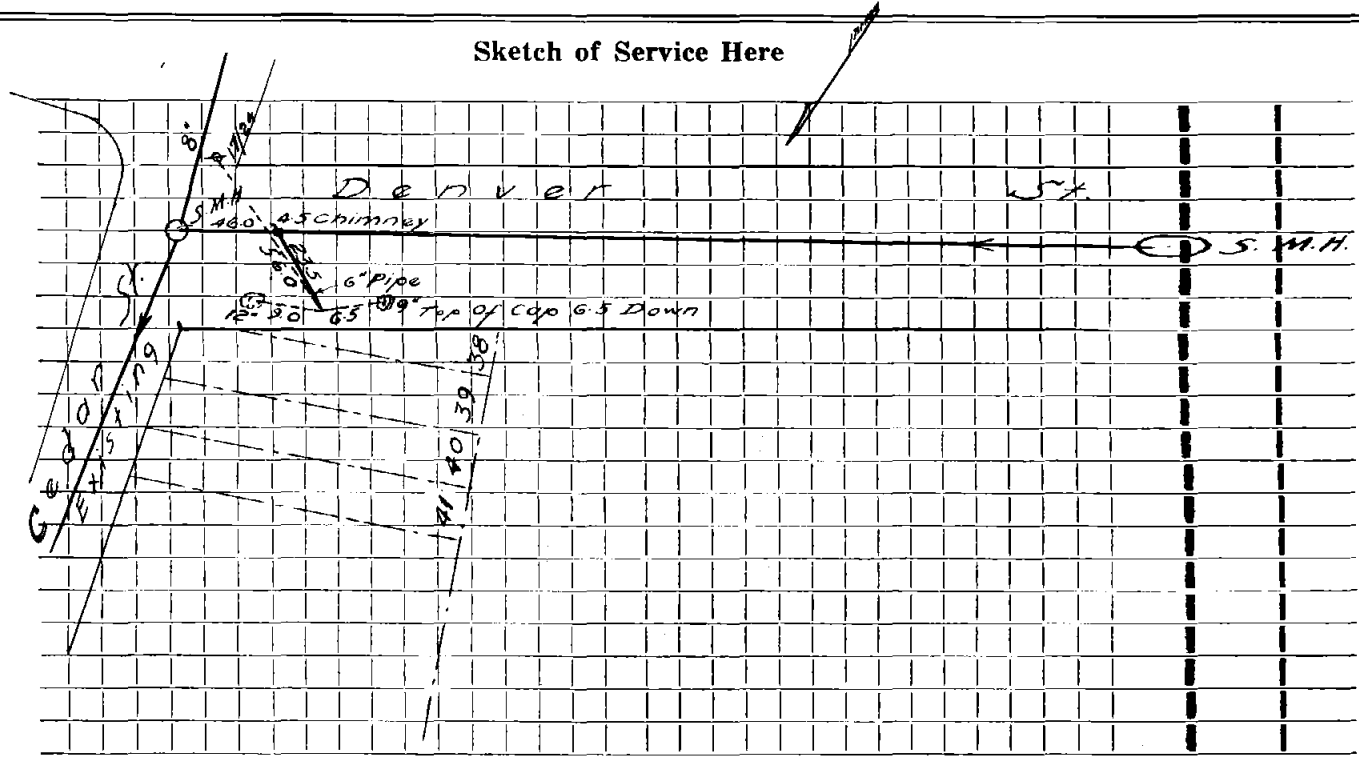

Connection made in \_\_\_\_\_ Street. Work completed \_\_\_\_\_

Remarks: \_\_\_\_\_  
\_\_\_\_\_  
\_\_\_\_\_