

Name Roger Goldman

Service No. 2

Address 7 Denver Street

Location

Kind of Pipe

Size

Size of Main

~~REPAIR WORK~~ **New Service** Kirkland & Shaw #3696

Location JUL 20 1982


Date		Material	Amount	Total	Date		Amount
5	24¹/₂	6" Transite pipe @ 6.00		147.00	4-28-82	Deposit	147.00
5/82	93'	6" PVC					
		6" x 4" Conut					
		6" x 45° Elbow			1965		
		PVC x ACP Adaptor			24 ¹ / ₂	6" Transite	

DATE _____

TOWN OF LEXINGTON — BOARD OF PUBLIC WORKS

SEWER DIVISION

Sketch of Service Here **7**

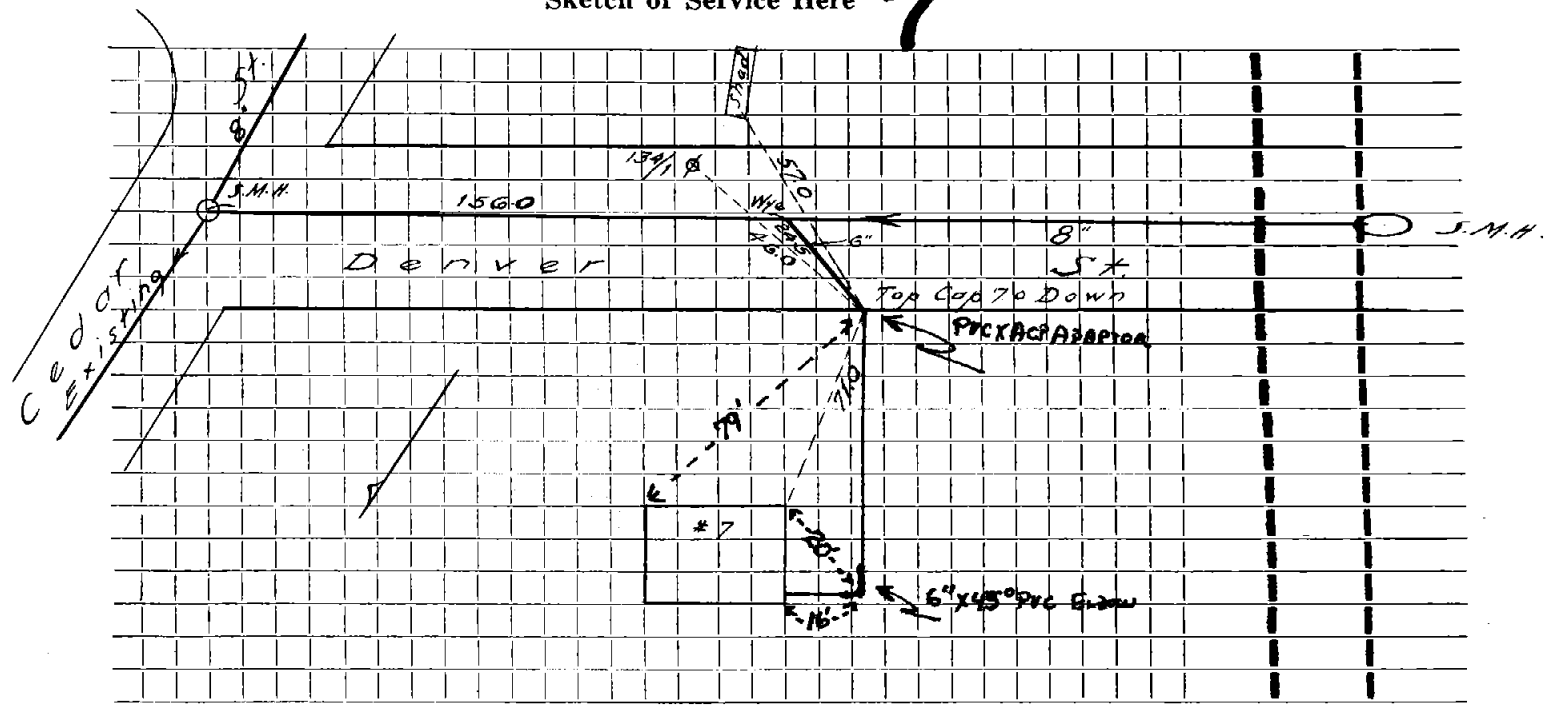

Connection made in Street. Work completed

Remarks:
.....
.....