


DATE _____

TOWN OF LEXINGTON — BOARD OF PUBLIC WORKS

SEWER DIVISION

Sketch of Service Here **14**

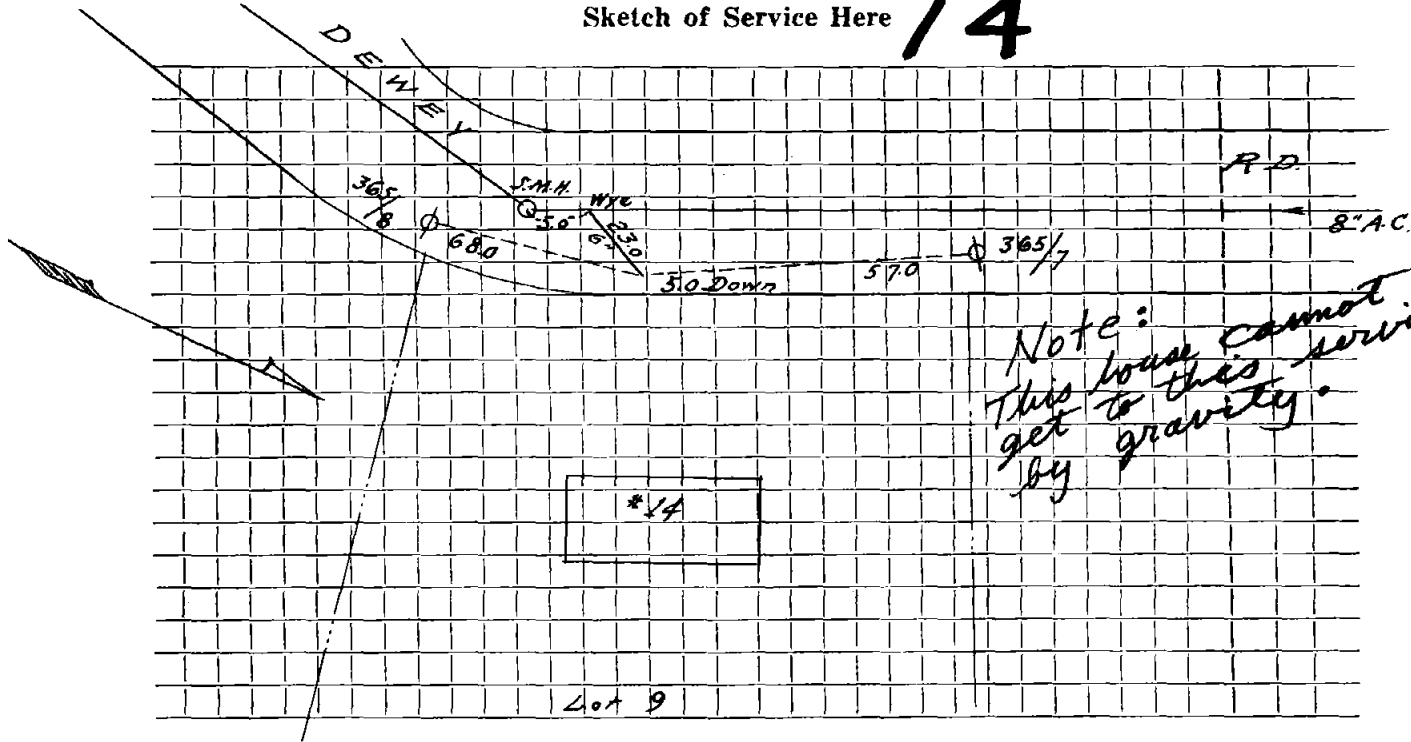

Note:
This house cannot
get to this service
by gravity.

Connection made in Street. Work completed

Remarks:
.....
.....